

Form OR-010-7300-2
4/83


UNITED STATES
DEPARTMENT OF THE INTERIOR
BUREAU OF LAND MANAGEMENT

Section

12 NWSW
T 36 S
R 28 E

Blocks Canyon
(5518)

Appl. No. R-66287
Permit No. **R10572**

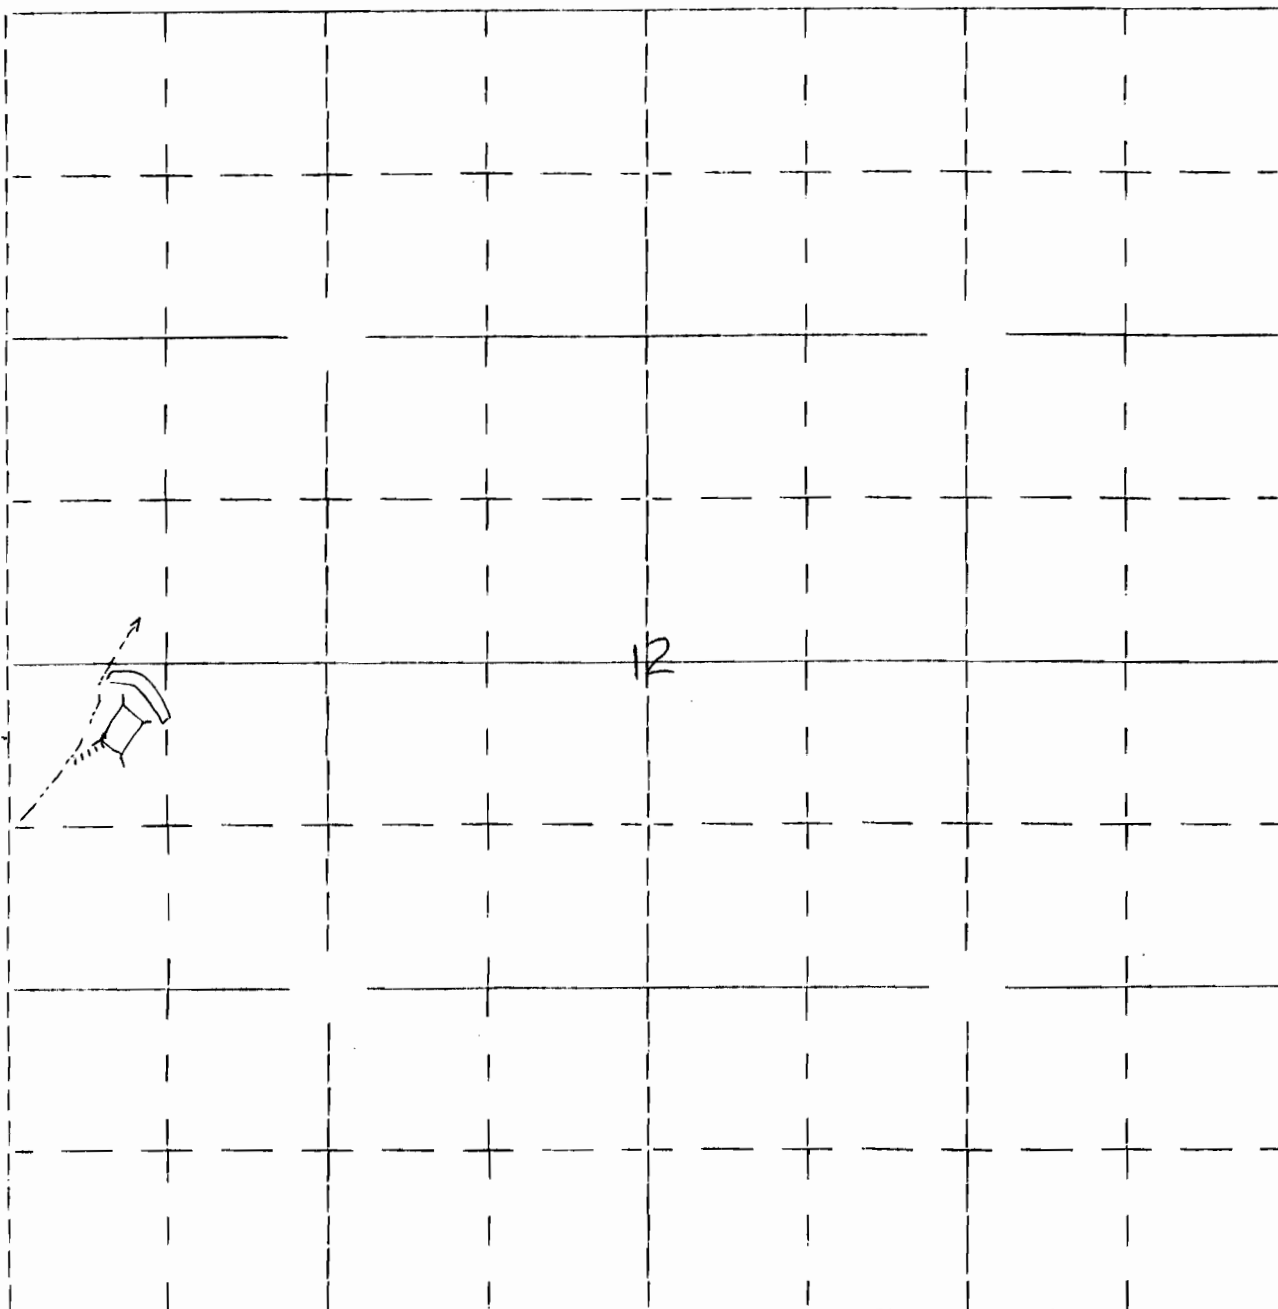

2372' North and 400' East
of the SW corner of Sec 12.