

74708

Form OR-010-7300-2  
4/83

UNITED STATES  
DEPARTMENT OF THE INTERIOR  
BUREAU OF LAND MANAGEMENT


Section  
21  
SWNW

Township 40 south  
Range 23 east

Appl. No. R-66297  
Permit No. R10581

Will. Mer.

O'Keefe Reservoir #7 (#4695)

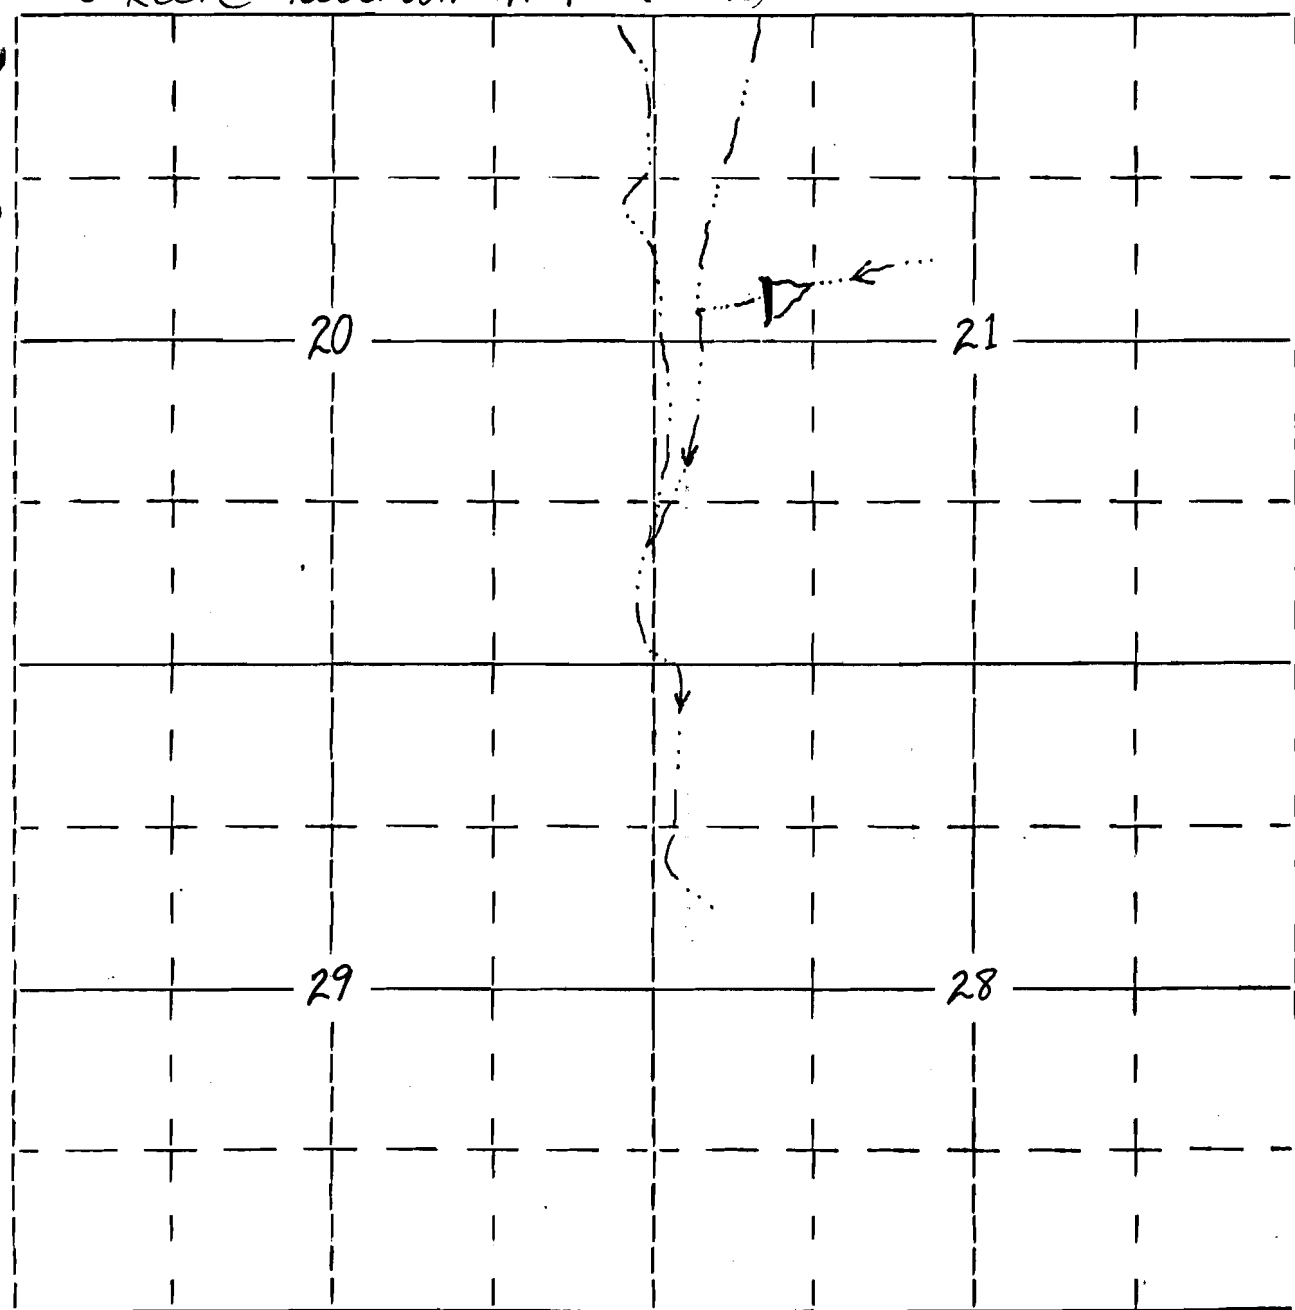

2510' S., 1620' E. of the NW corner of Section 21