


RECEIVED

SEP 26 1983

WATER RESOURCES DEPT.
SALEM, OREGON

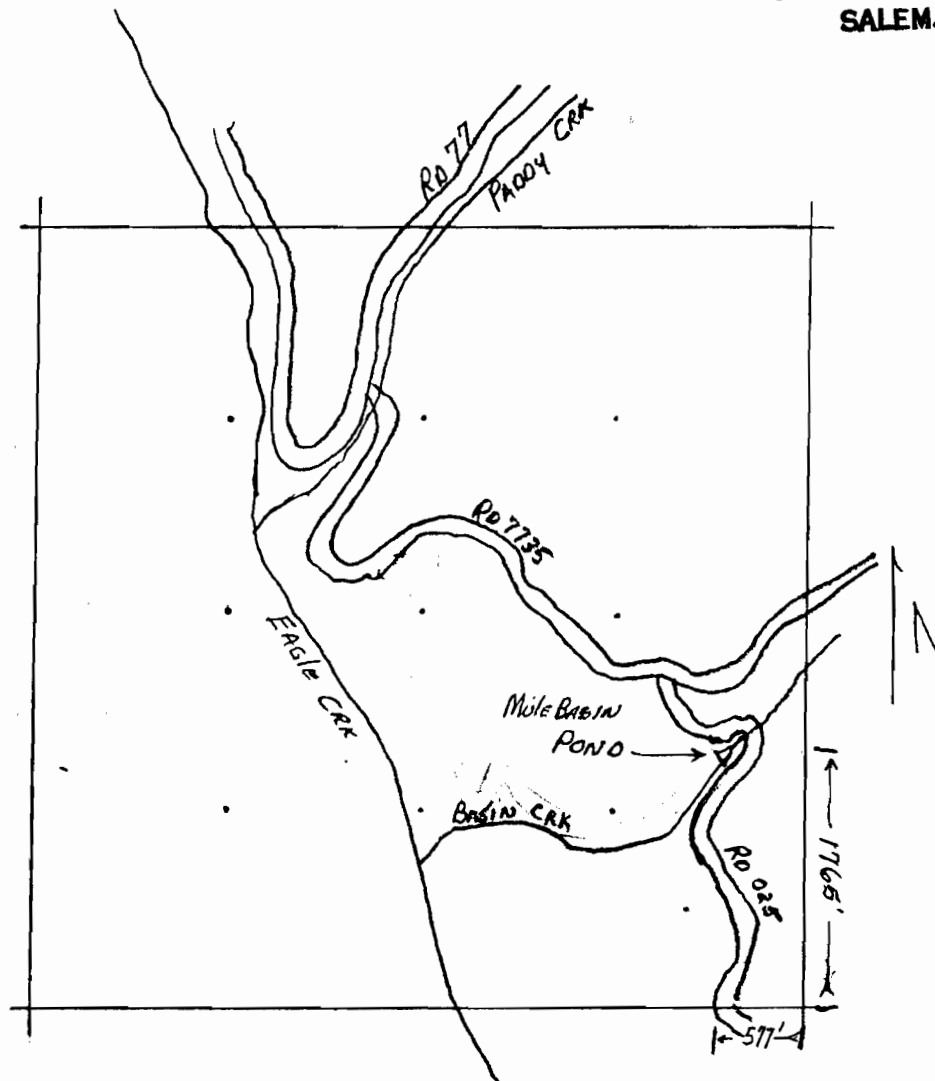

1/4 inches = 1 mile

T 7 S R 44 E Sec 21

Application No.
Permit No.

R-66732
R11065