

R 8960
74720

Form OR-010-7300-2
4/83

UNITED STATES
DEPARTMENT OF THE INTERIOR
BUREAU OF LAND MANAGEMENT

Section 11

Township 30S

Appl. No. R-67382


NESE

Range 28E

Permit No. R 8960

Will. Mer.

Robinson Valley Reservoir #5138

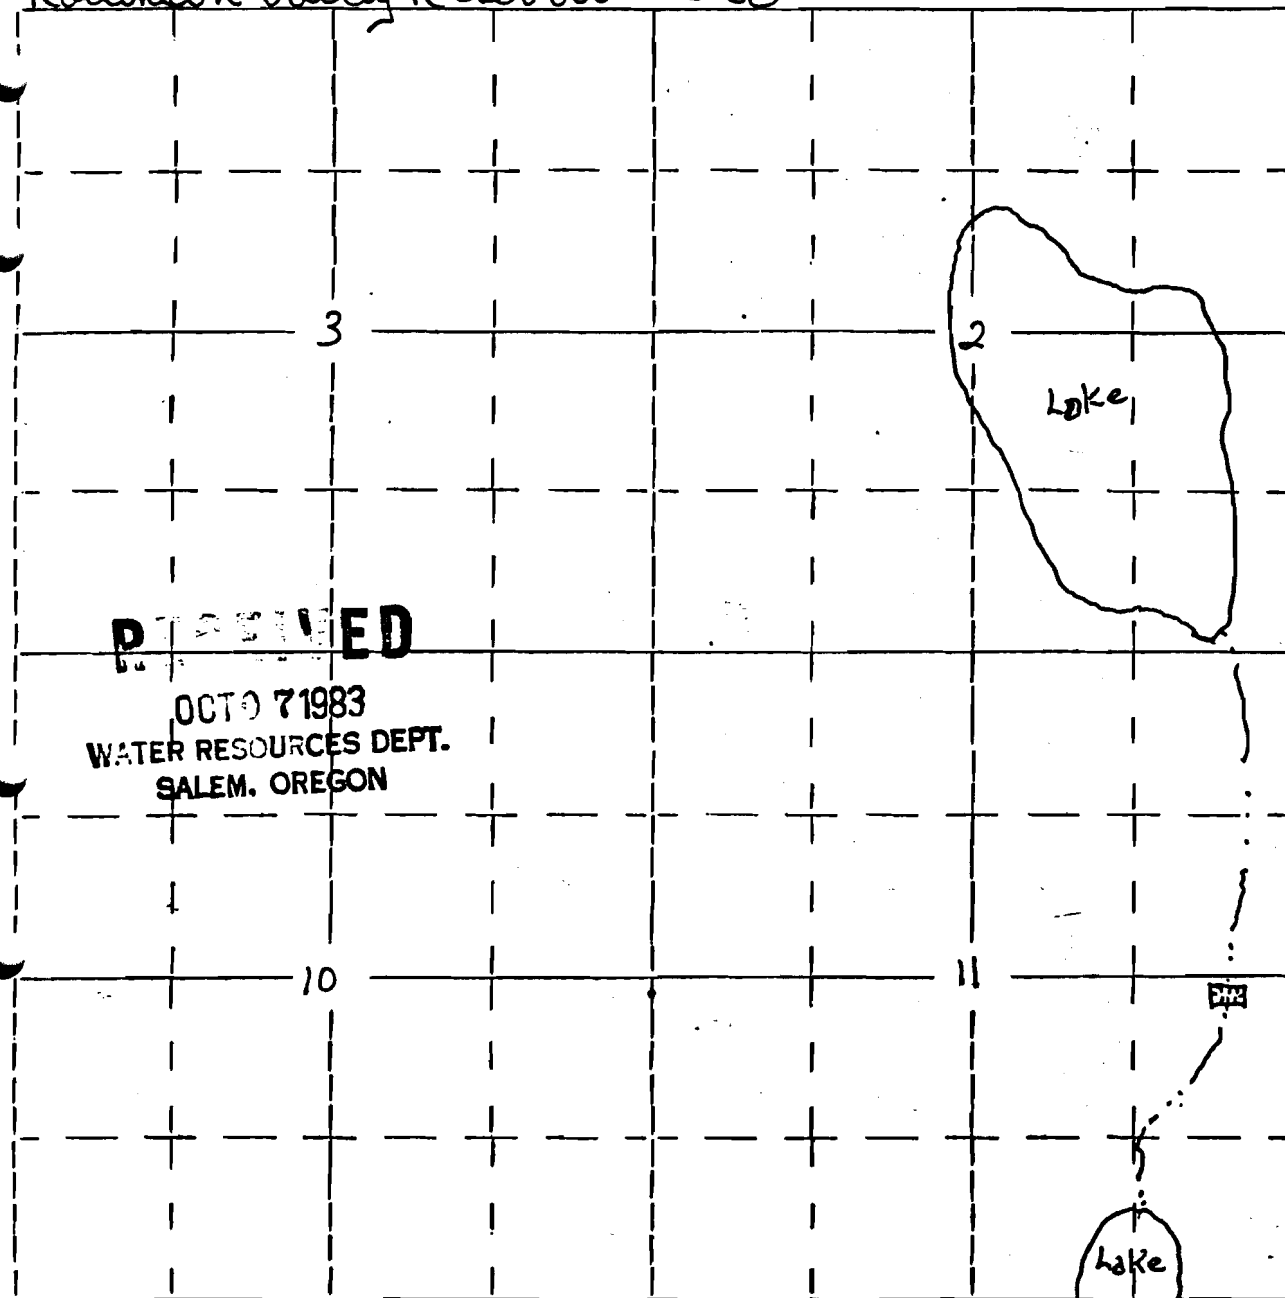

2600' N 350' W of SE corner of section 11