

R 8961
74721

Form OR-010-7300-2
4/83

UNITED STATES
DEPARTMENT OF THE INTERIOR
BUREAU OF LAND MANAGEMENT

Section 16
NESE


Township 31S
Range 25E

Appl. No. R-67383
Permit No. R 8961

Will. Mer.

Moss Draw Reservoir #5236

RECEIVED
OCT 9 7 1983
WATER RESOURCES DEPT.
SALEM, OREGON

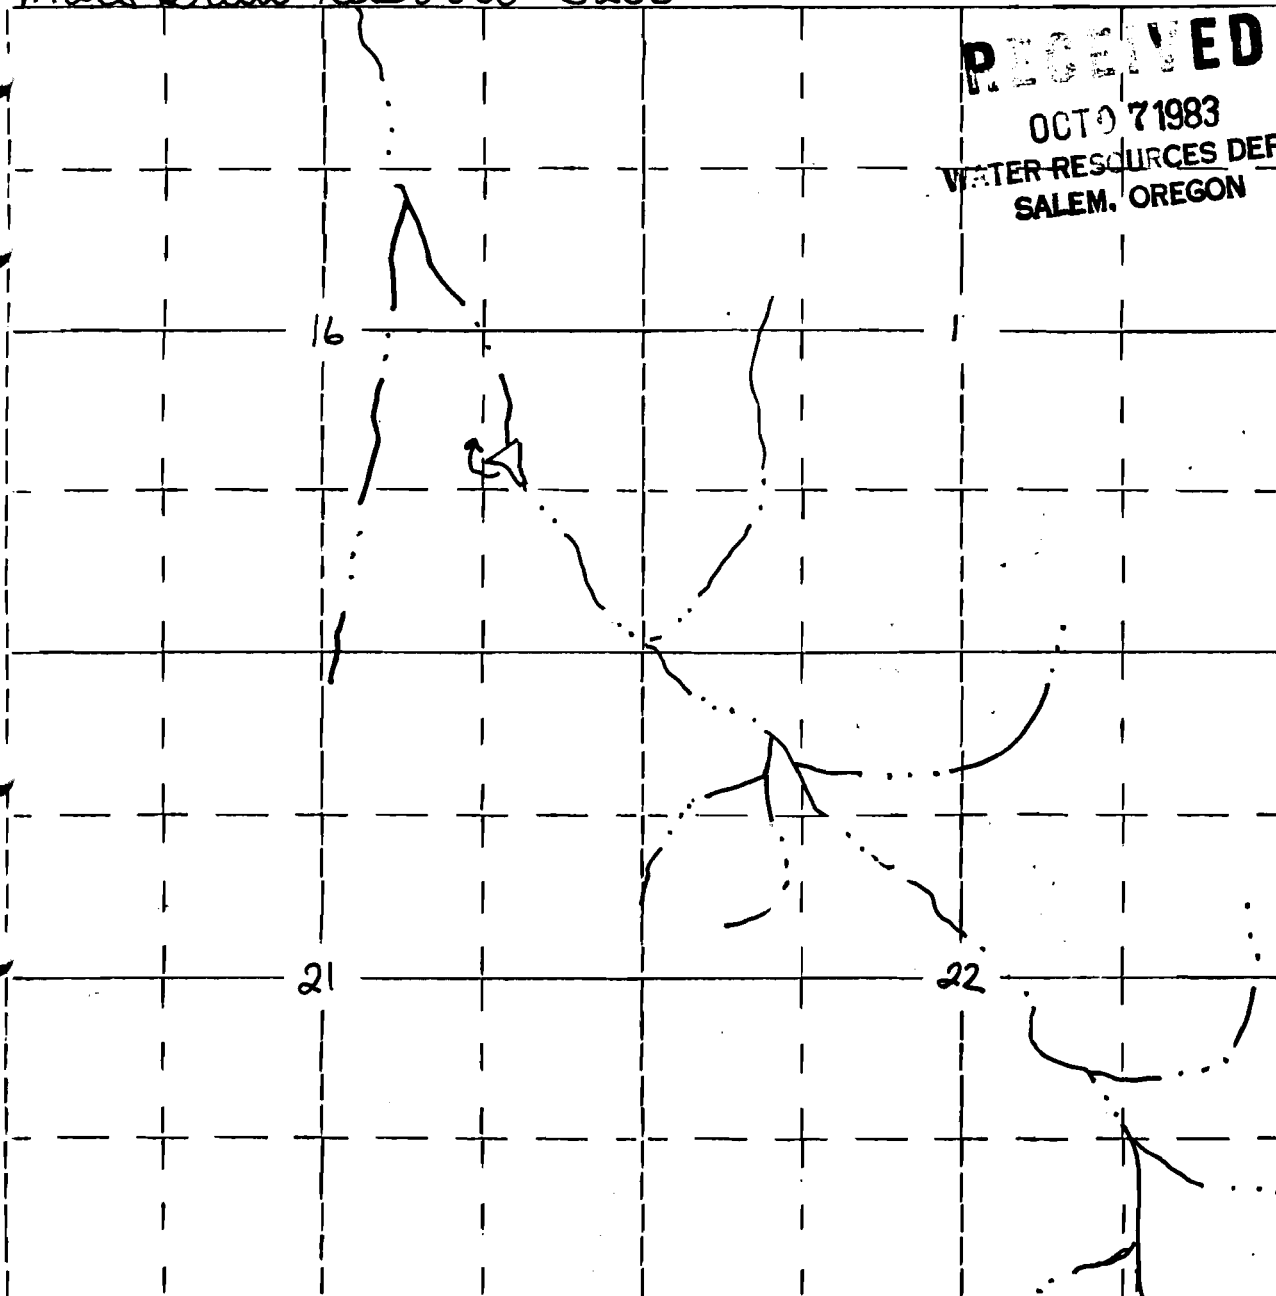

1425' N & 1,150' W of SE corner of Section 16