

R8969
74723

Form OR-010-7300-2
4/83

UNITED STATES
DEPARTMENT OF THE INTERIOR
BUREAU OF LAND MANAGEMENT

Section

6

NW SE

T. 38 S.


R. 24 E.

WM.

Appl. No. R-67391

Permit No. R 8969

Horse Waterhole #0970

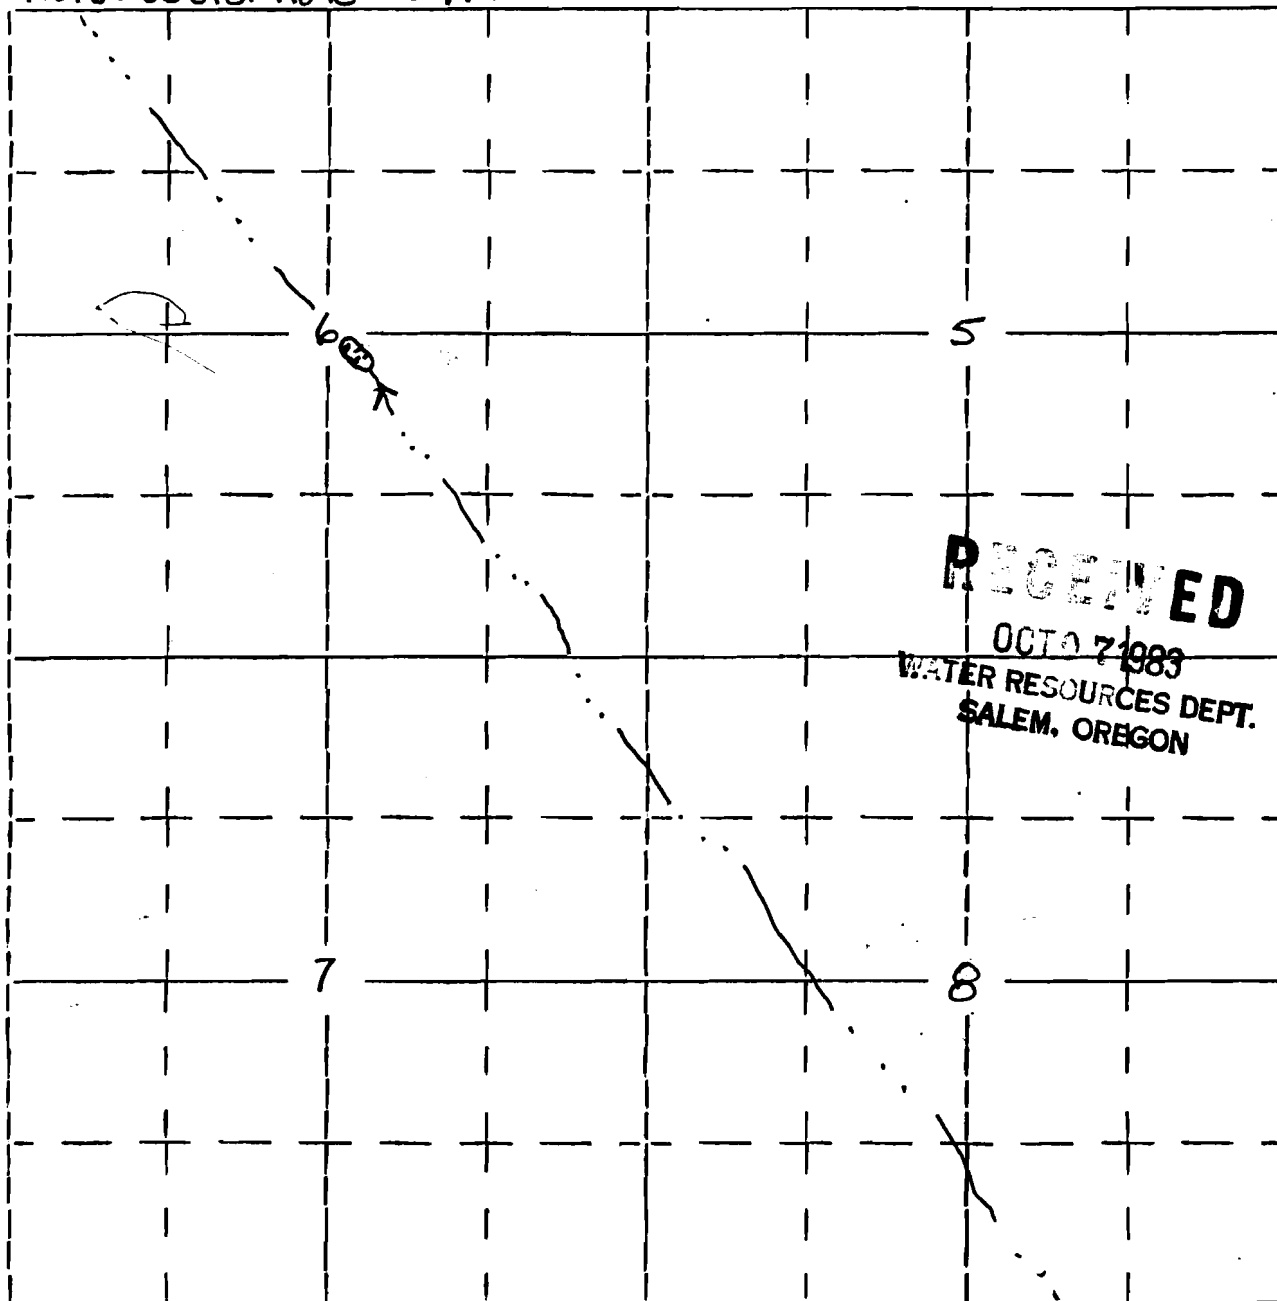

2600' N, 2600' W of the SE corner of Section 6