

R8977  
74724

Form OR-010-7300-2  
4/83

UNITED STATES  
DEPARTMENT OF THE INTERIOR  
BUREAU OF LAND MANAGEMENT

Section

14

Township

40S

Appl. No.

R-67400

SWSW

Range


22E

Permit No.

R 8977

Will. Mer.

Rim W.H. 4058

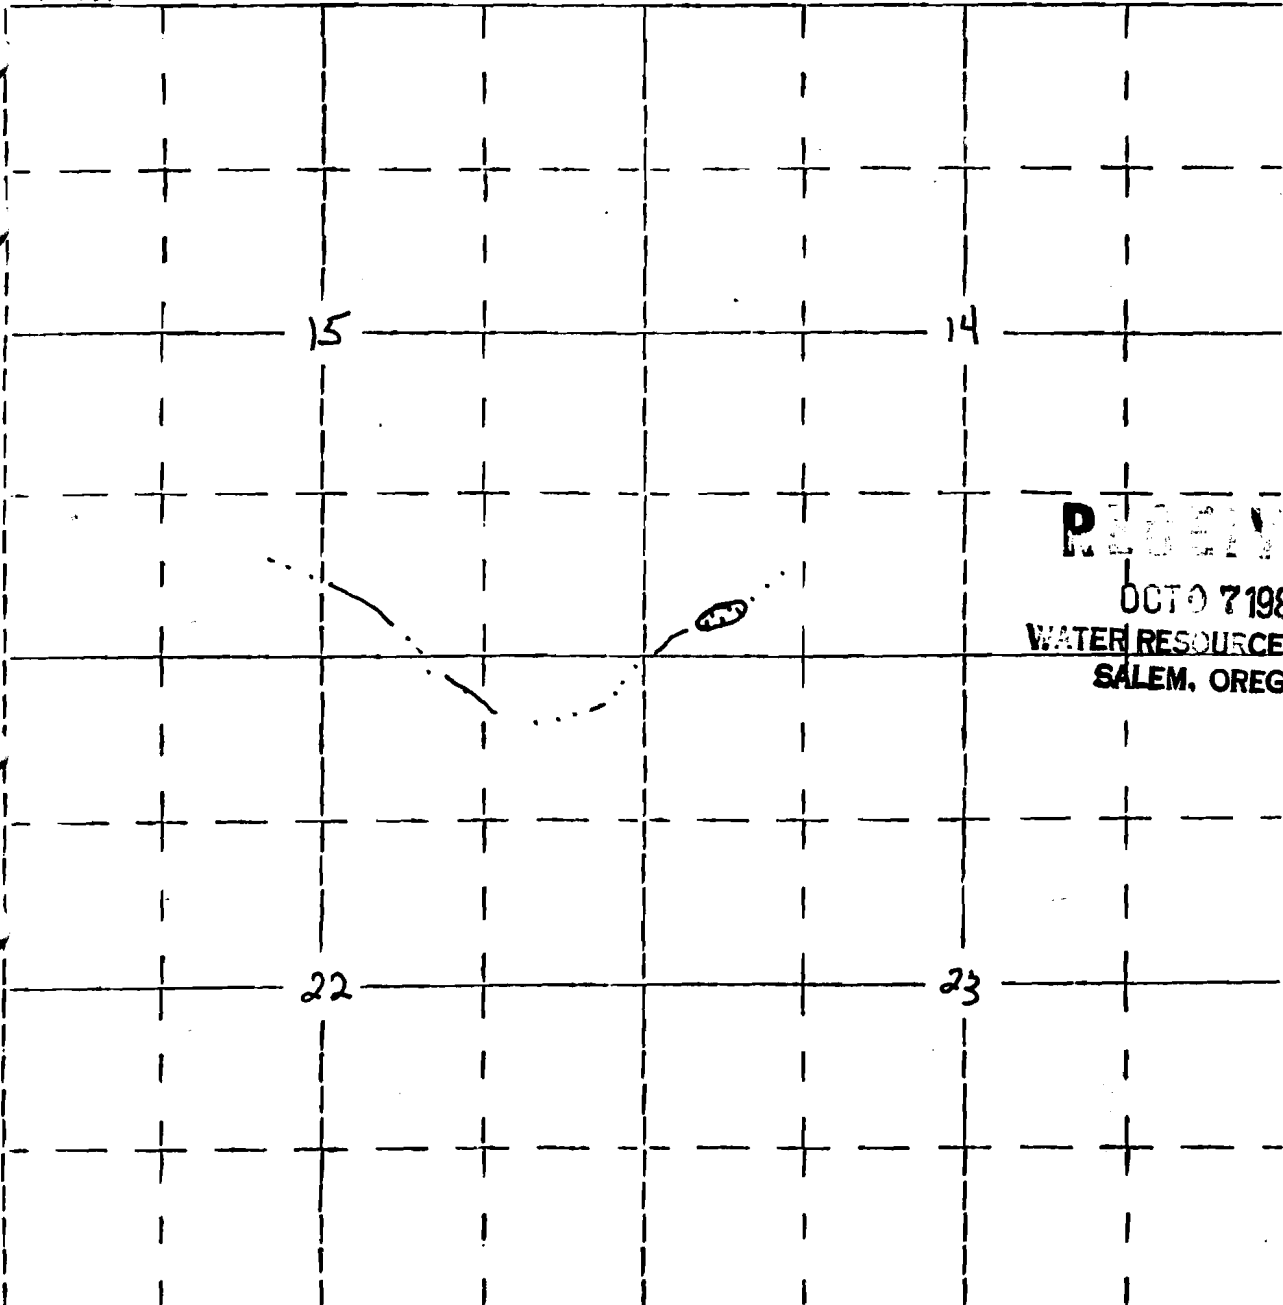

**RECEIVED**

OCT 07 1983

WATER RESOURCES DEPT.  
SALEM, OREGON

300' N 800' E of the SW corner of section 14