

R 8981  
74725

Form OR-010-7300-2  
4/83

UNITED STATES  
DEPARTMENT OF THE INTERIOR  
BUREAU OF LAND MANAGEMENT

Section

12

Township 31 S

Appl. No. R-67404


NE NE

Range 23 E

Permit No. R 8981

Will. Mer.

County Line WH. (#0599)

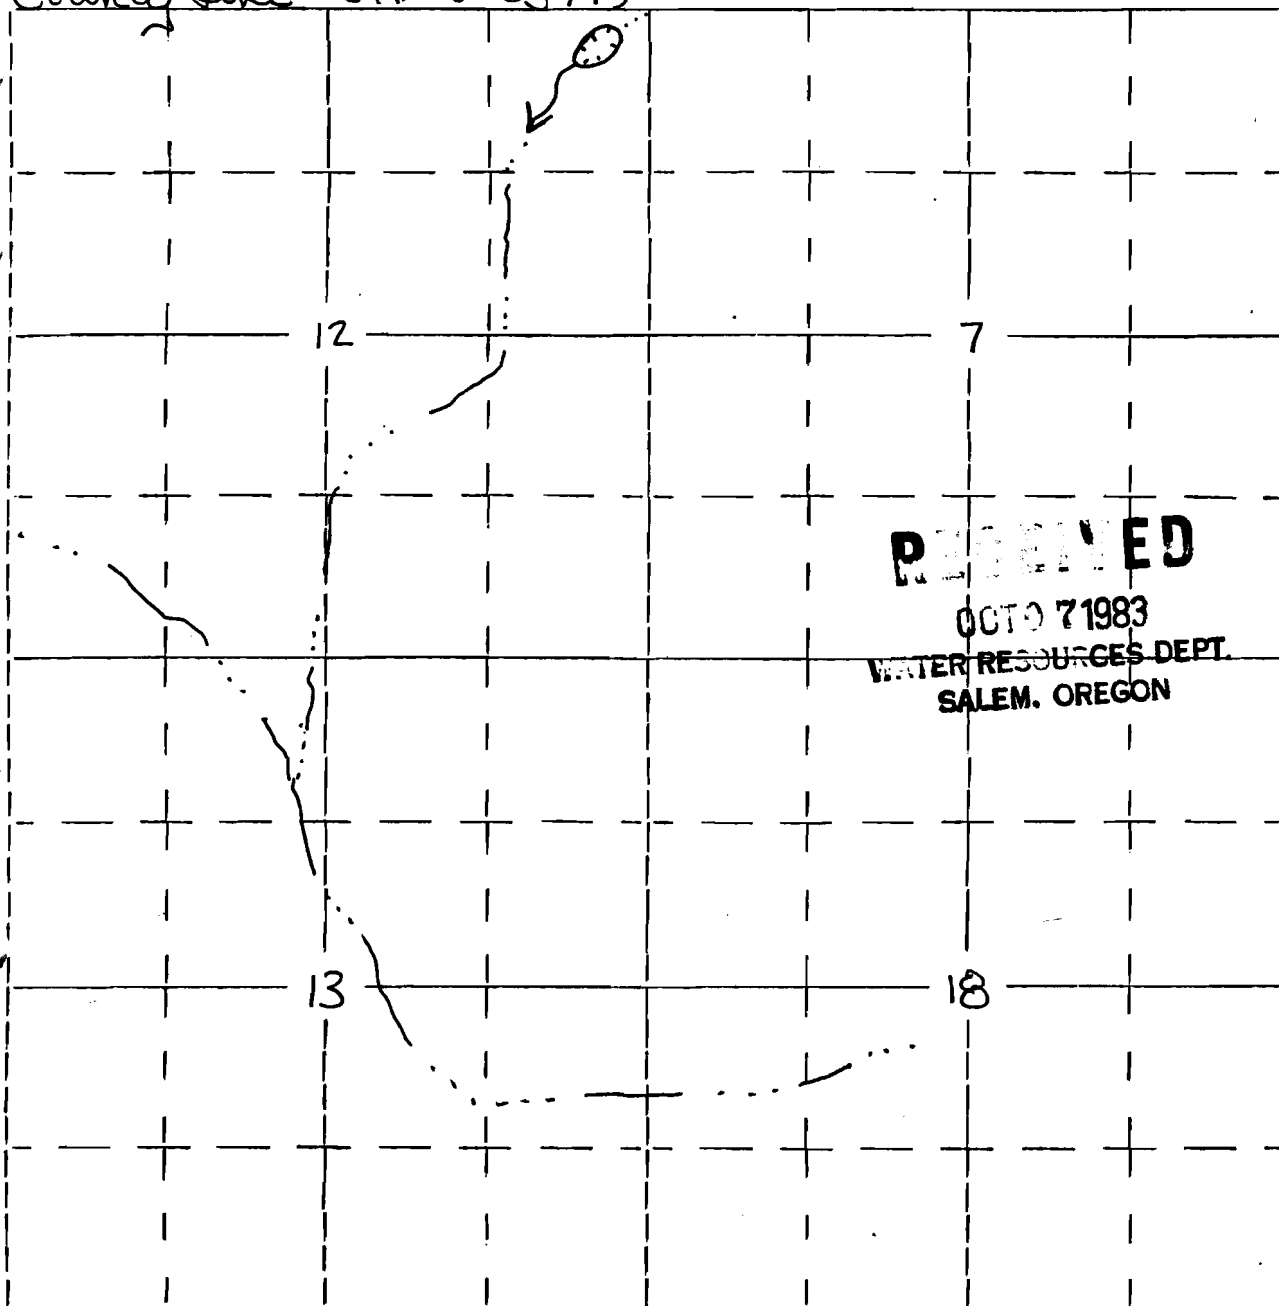

700' S. 500' W. of NE corner of section 12