

R8984
74726

Form OR-010-7300-2
4/83

UNITED STATES
DEPARTMENT OF THE INTERIOR
BUREAU OF LAND MANAGEMENT

Section

7

Township 31S

Appl. No. R-67408


NWSW

Range 24E

Permit No. R 8984

Will. Mer.

Pick-up Waterhole (#0601)

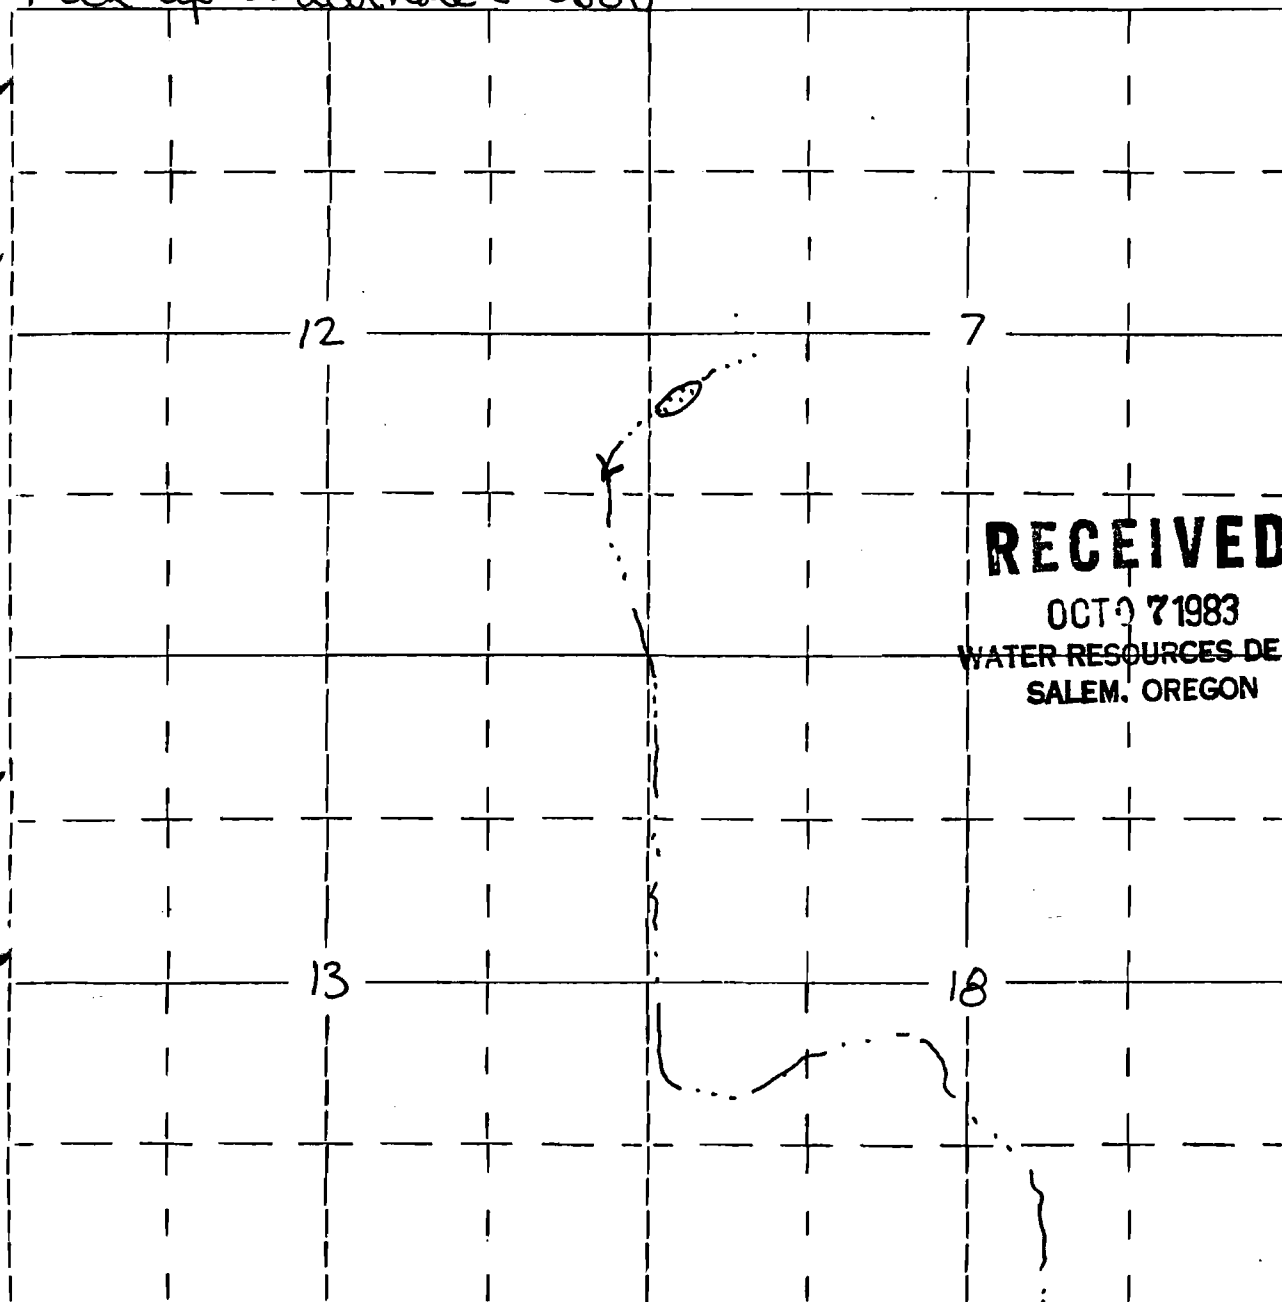

1,700' N. 600' E. of SW corner of section 7.