


Section 23
NE NE

Township 28 south
Range 17 east

Appl. No. R67657

Permit No. R 9514

Upper Sheep Corral Res. (#4129)

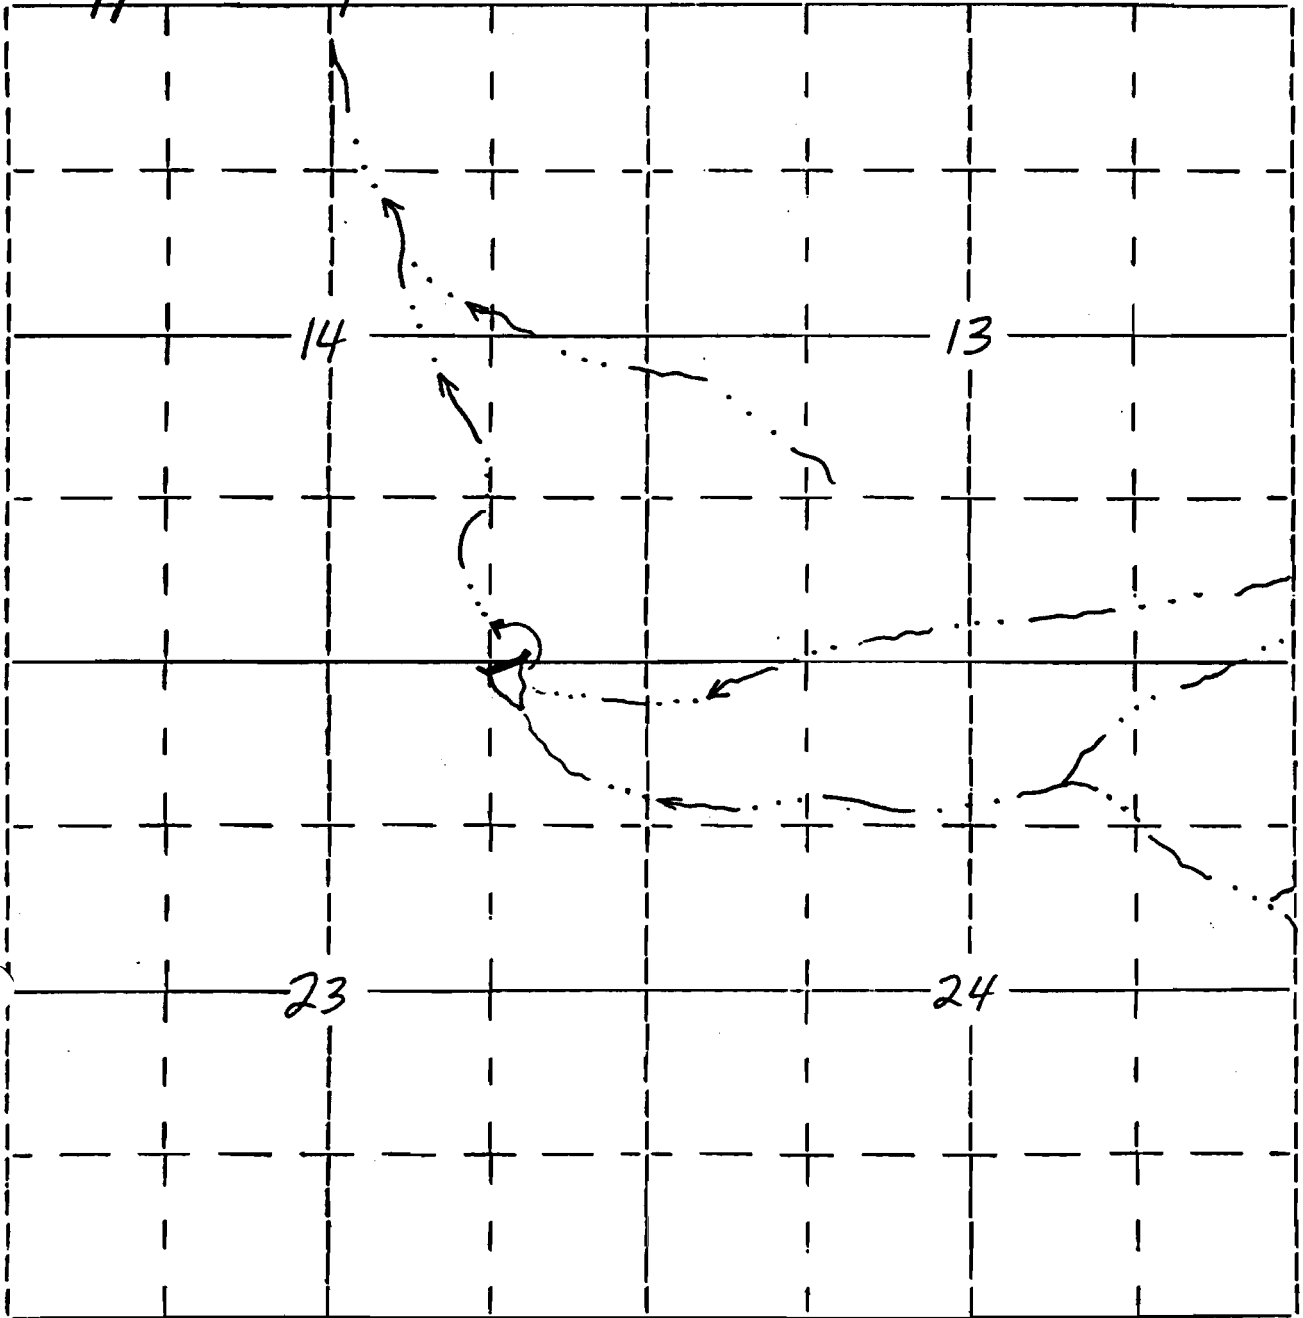

20' S., 1190' W. of NE Corner, sec. 23

