


Section 28
SE NE

Township 28 south
Range 16 east

Appl. No. R67664
Permit No. R 9520

Indian Skull Reservoir #1

3589

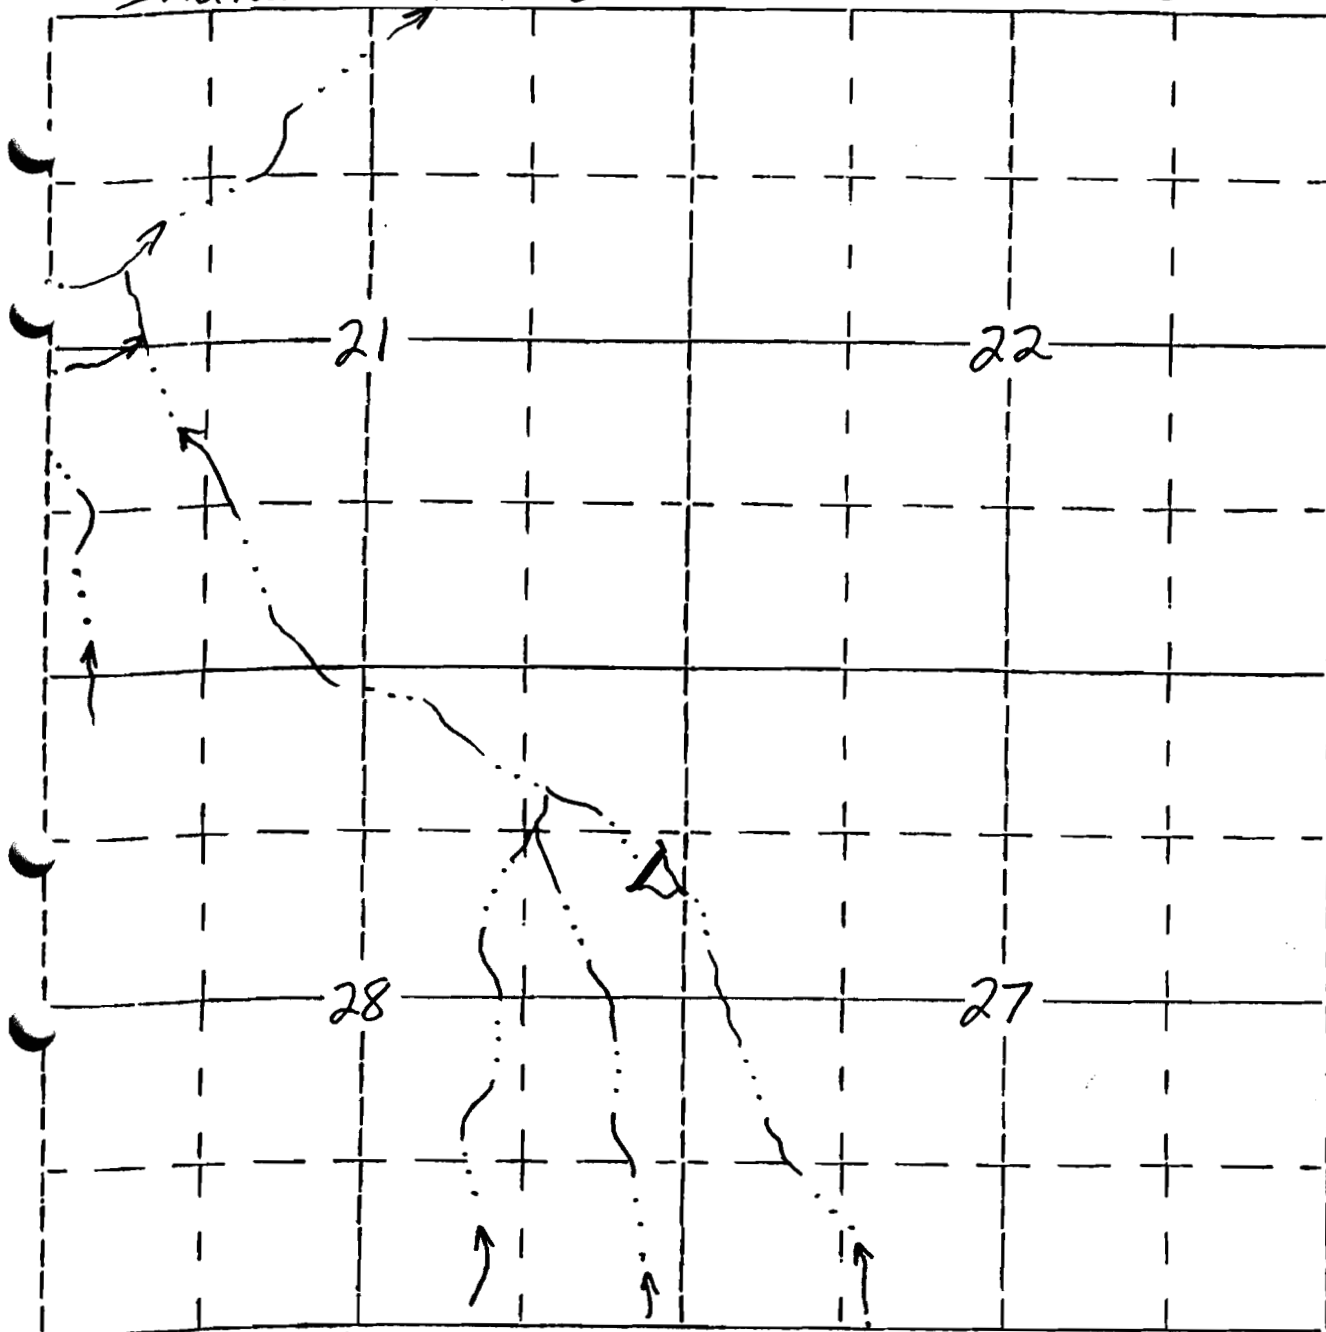

1585' S., 265' W. of NE Corner, section 28.