

R9529
74733

Form OR-010-7300-2
4/83

UNITED STATES
DEPARTMENT OF THE INTERIOR
BUREAU OF LAND MANAGEMENT


Section 11
NW NW

Township 29 south
Range 16 east

Appl. No. R67673
Permit No. R 9529

Egli Rim Reservoir #1

5247

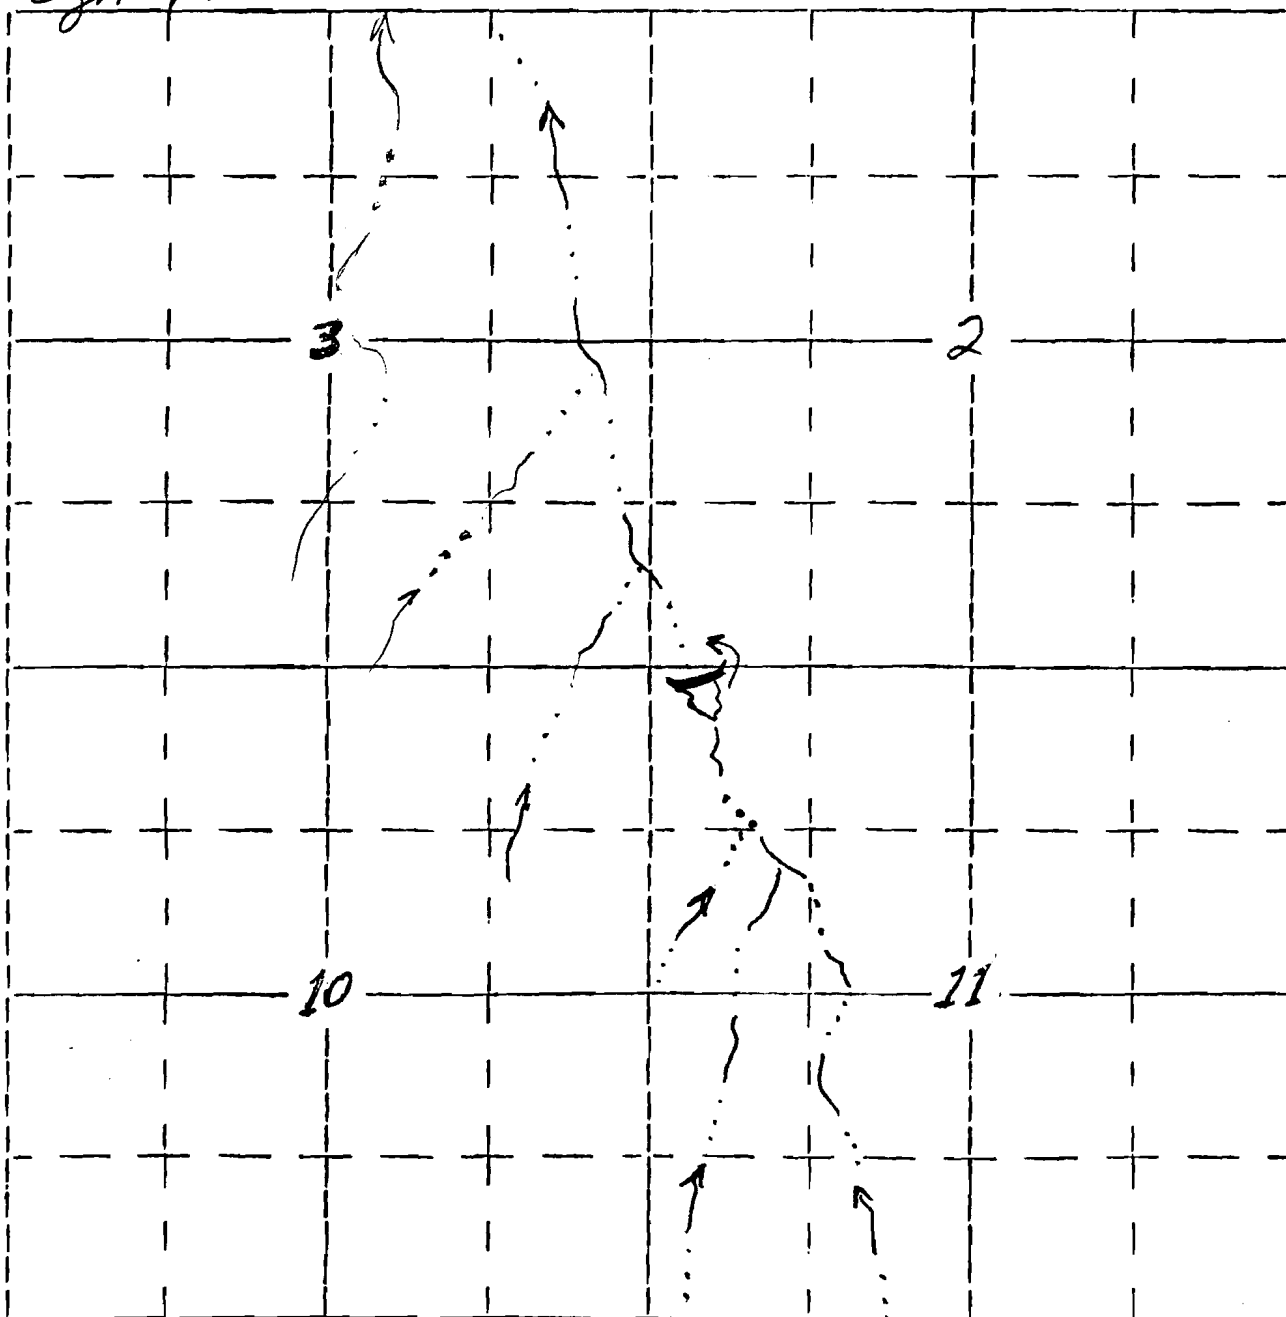

845' E., 115' S. of NW Corner, section 11