

SECTION

SE

SW 1/4 of NW 1/4

Sec 30

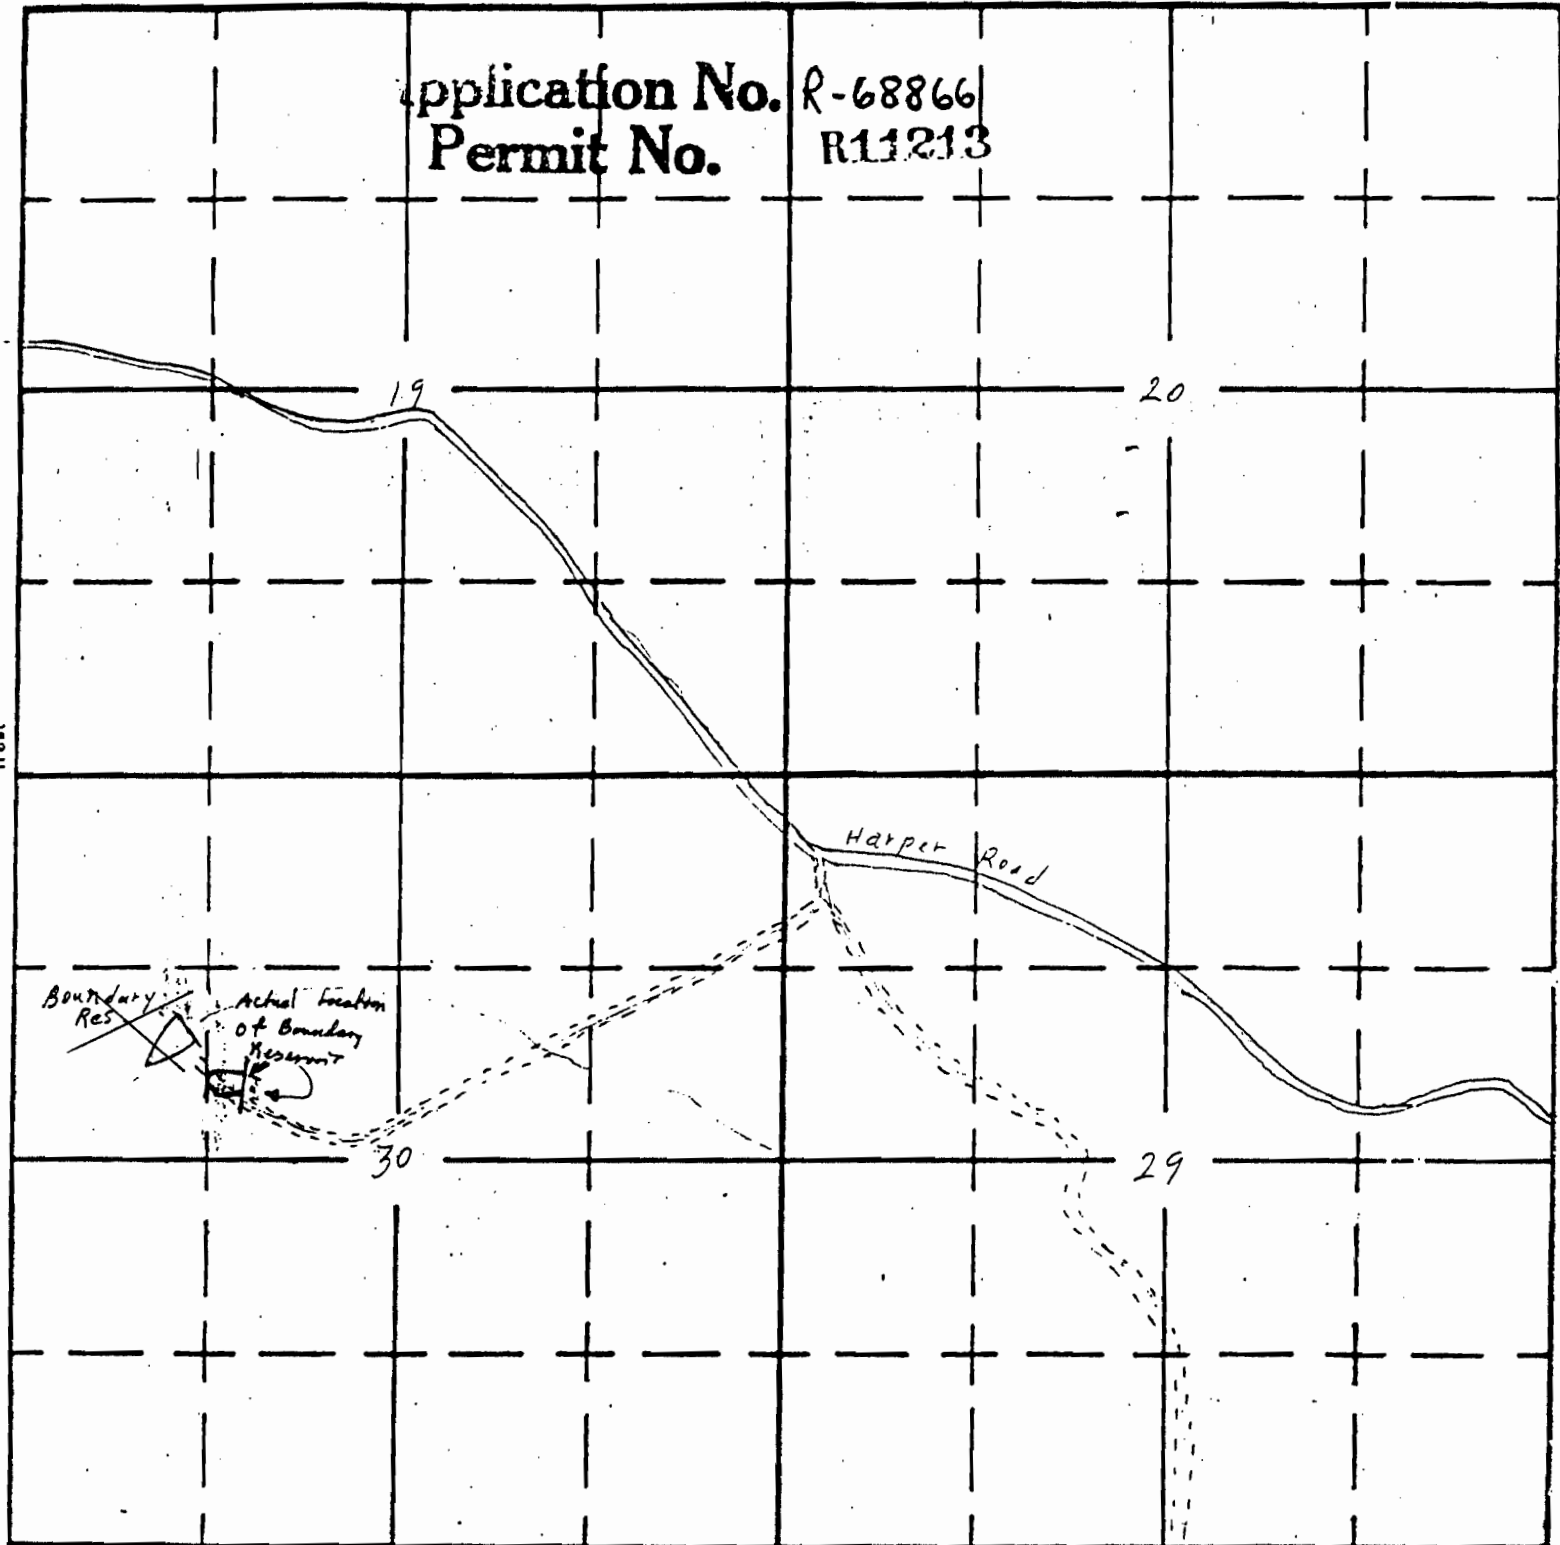
Oregon State Water Filings

RECEIVED

MAY - 6 1994

TOWNSHIP 23S, RANGE 40E, W. M.WATER RESOURCES DEPT.
SALEM, OREGON

North

Application No. R-68866
Permit No. R11213

South

APPLICATION No. R-68866
PERMIT No.