

Form A1-187
March 1961

UNITED STATES
DEPARTMENT OF THE INTERIOR
BUREAU OF LAND MANAGEMENT


SECTION

18 NWNE

Oregon State Water Filings

TOWNSHIP 32 S, RANGE 44 E, W. M.

North BIG PASTURE RES.

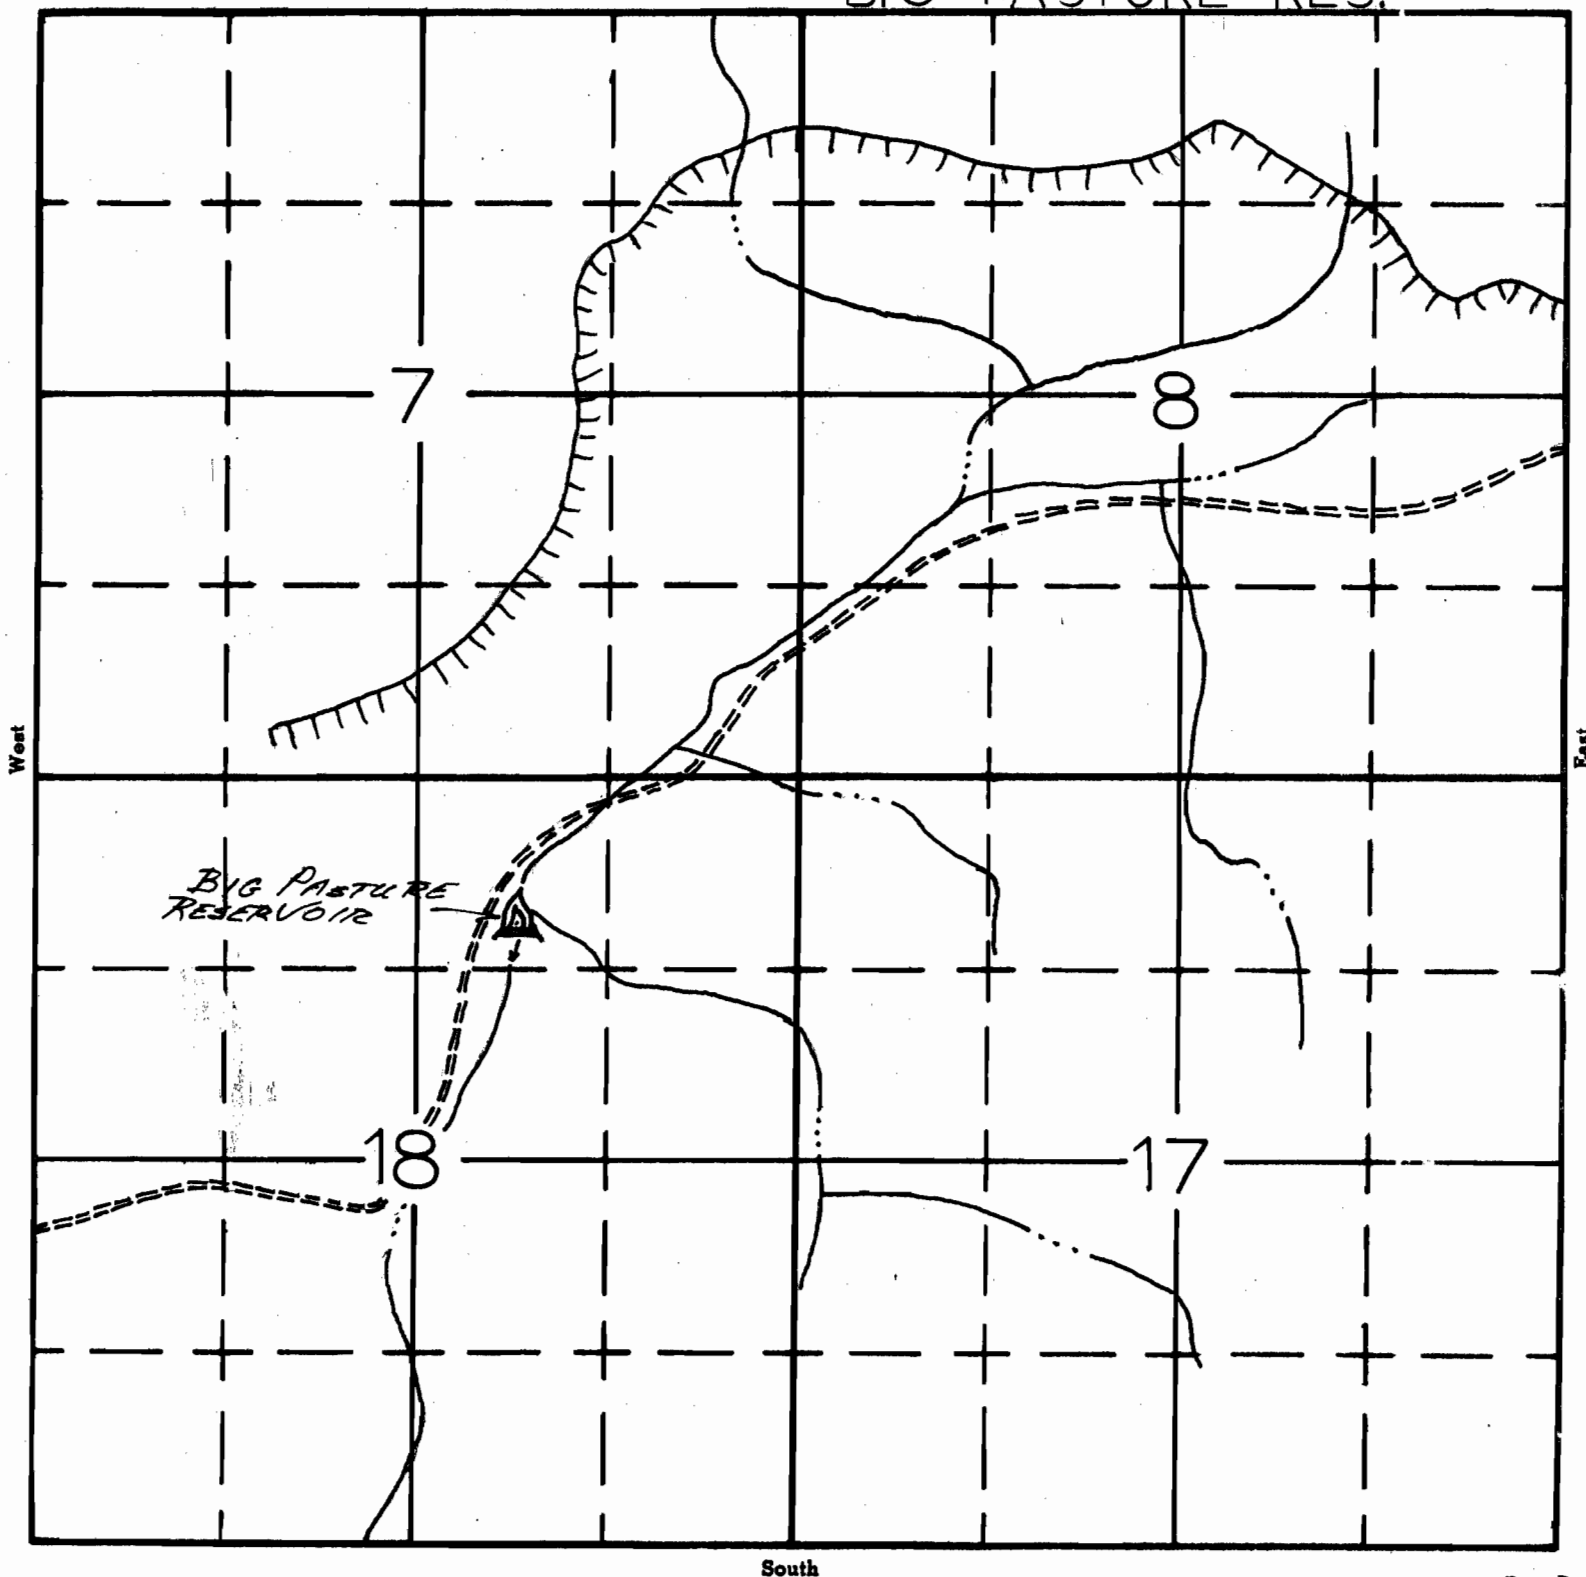

South

APPLICATION No. R-67840
R10658
PERMIT No.