

Form AI-187
March 1961

UNITED STATES
DEPARTMENT OF THE INTERIOR
BUREAU OF LAND MANAGEMENT


SECTION

19

NW 1/4 of SW 1/4

Oregon State Water Filings

TOWNSHIP 34S, RANGE 46E, W. M.

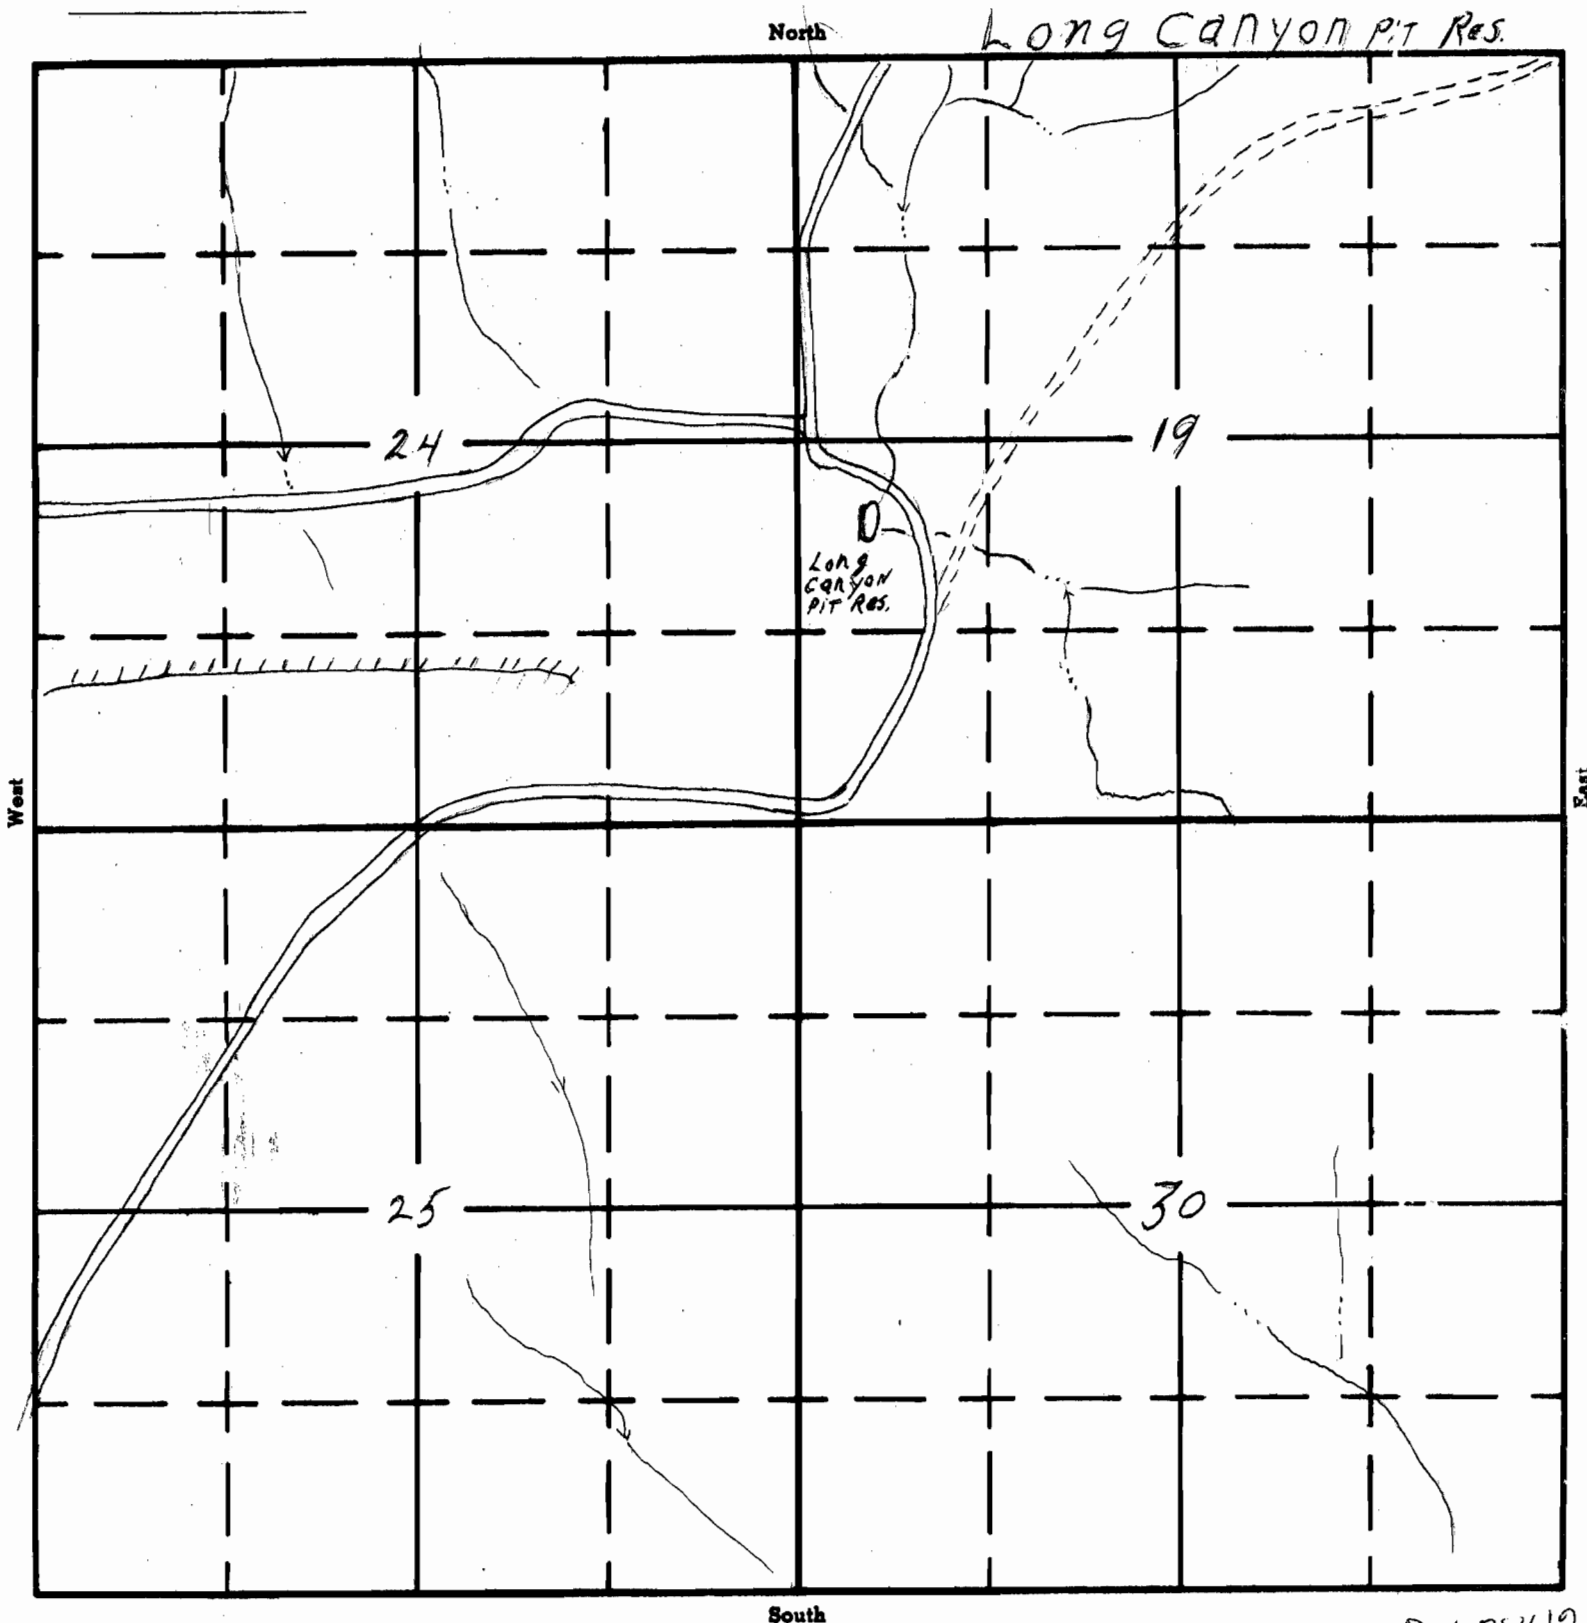

APPLICATION No. R-67842
R10660
PERMIT No.