

Form A1-187
March 1961

UNITED STATES
DEPARTMENT OF THE INTERIOR
BUREAU OF LAND MANAGEMENT


SECTION

6 SWNE

Oregon State Water Filings

TOWNSHIP 35 S, RANGE 45 E, W. M.

North SQUAW FLAT NO. 1 PIT

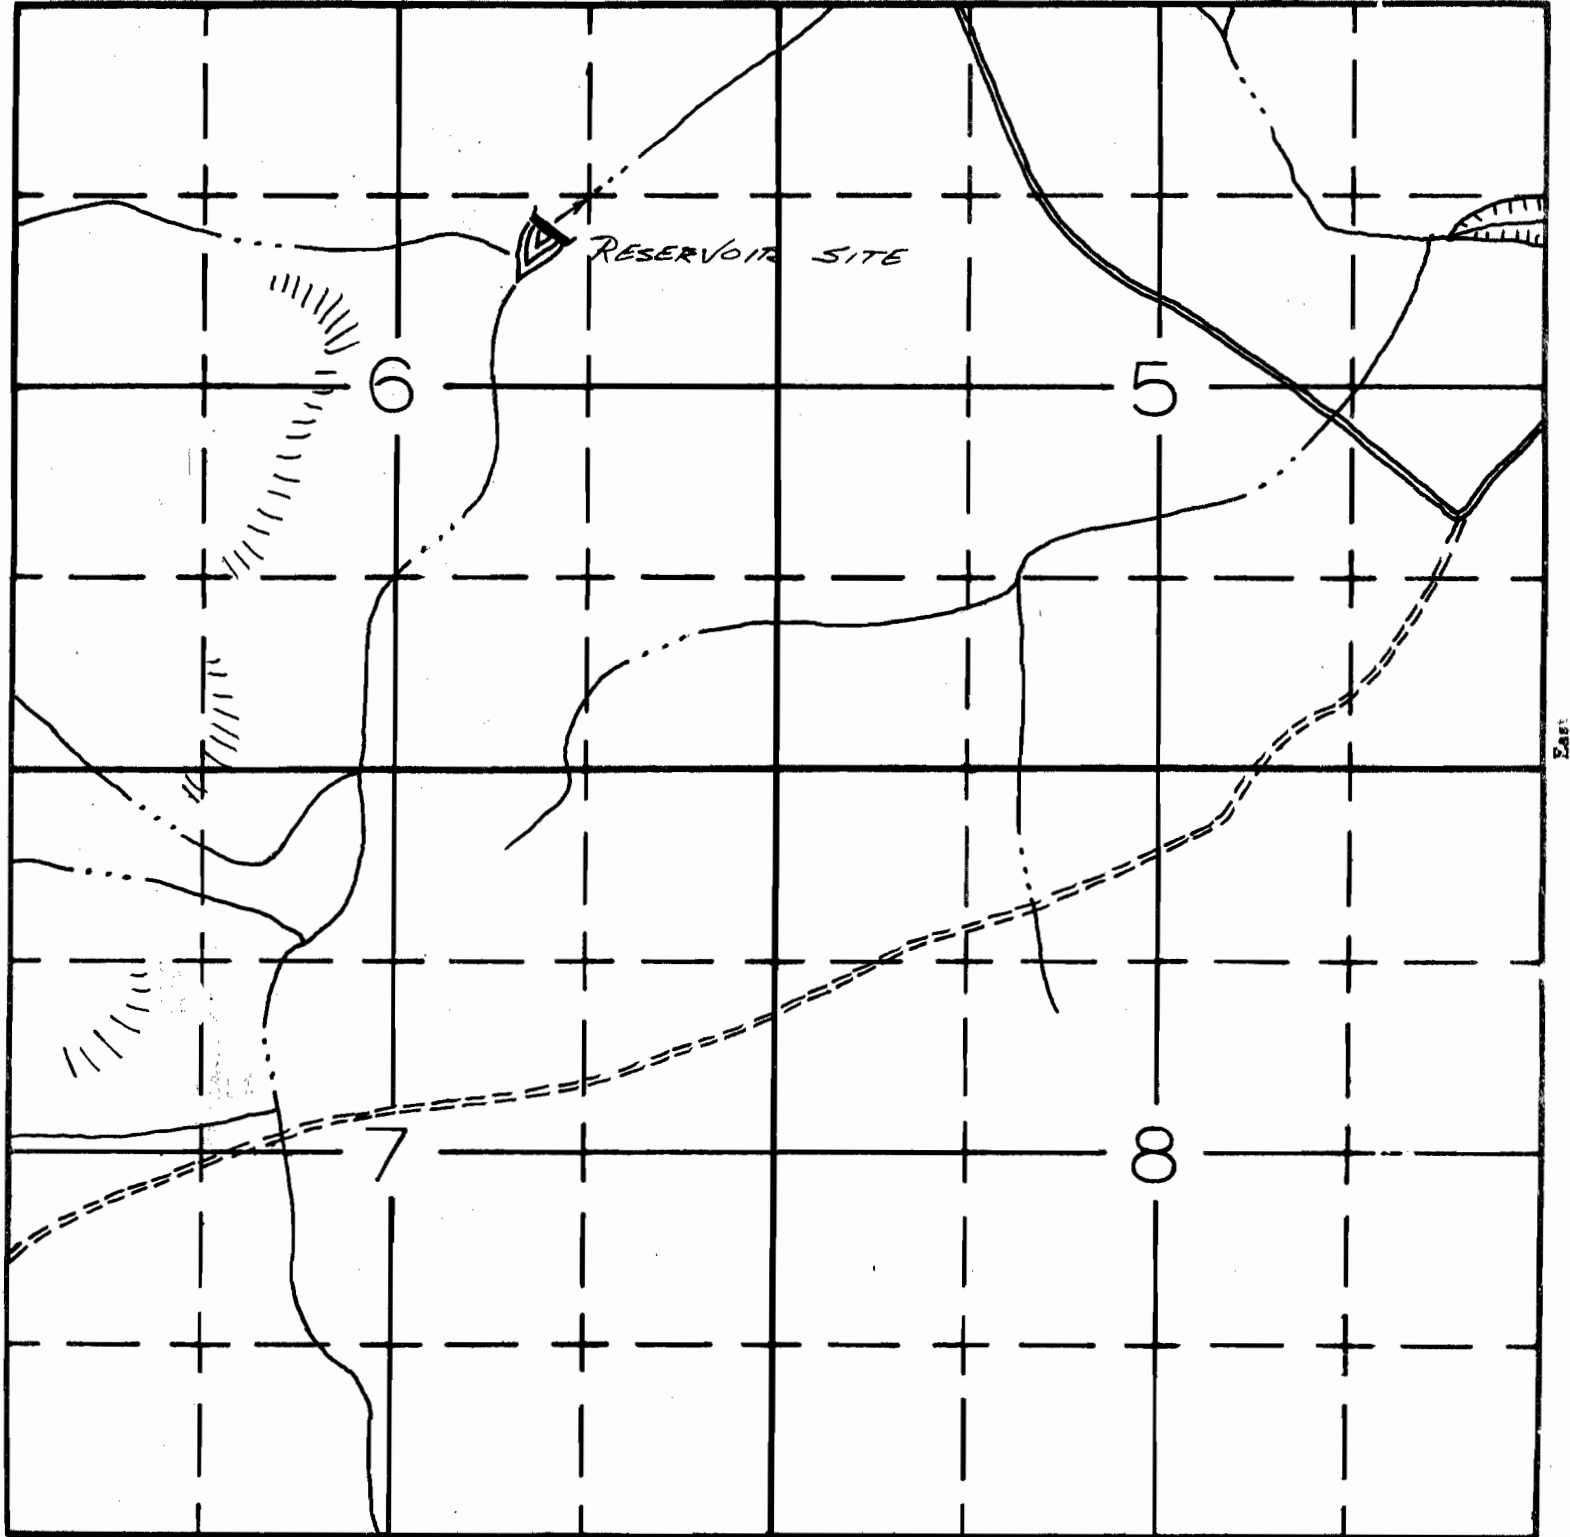

10-83

JA

South

APPLICATION No. R-67851
PERMIT No. R10665