

Form AI-187
March 1961

UNITED STATES
DEPARTMENT OF THE INTERIOR
BUREAU OF LAND MANAGEMENT


SECTION

SESE

Oregon State Water Filings

TOWNSHIP 26 S, RANGE 37 E, W. M.

North MCEWEN RESERVOIR

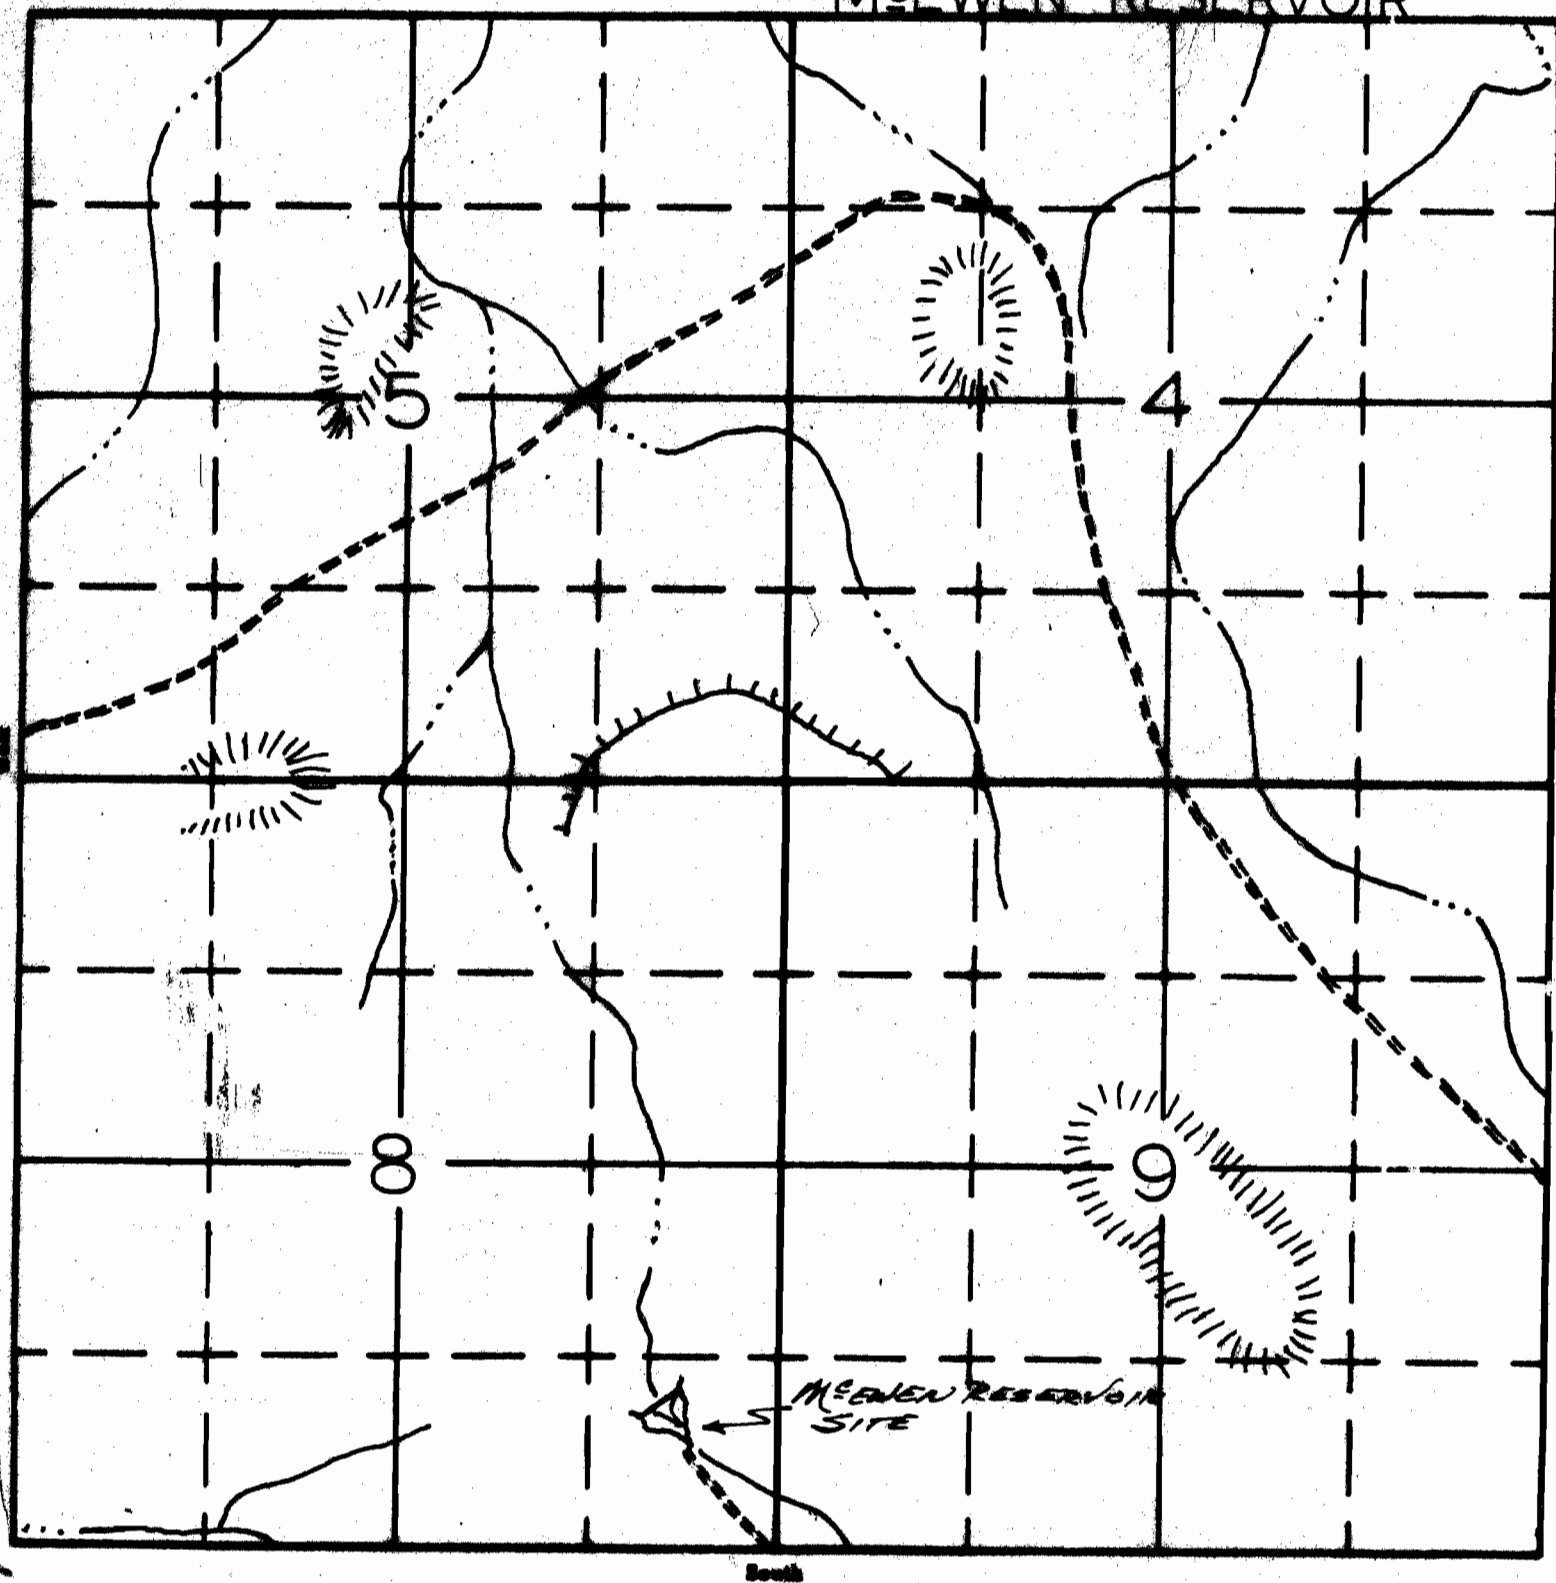

APPLICATION No. R-67874
PERMIT No. 10632