

Application No. R-68873

1-187
1961

UNITED STATES
DEPARTMENT OF THE INTERIOR
BUREAU OF LAND MANAGEMENT


Permit No. R11080

SECTION

Oregon State Water Filings

NW 1/4 NW 1/4
SEC. 30

TOWNSHIP 21 S, RANGE 39 E, W. M.

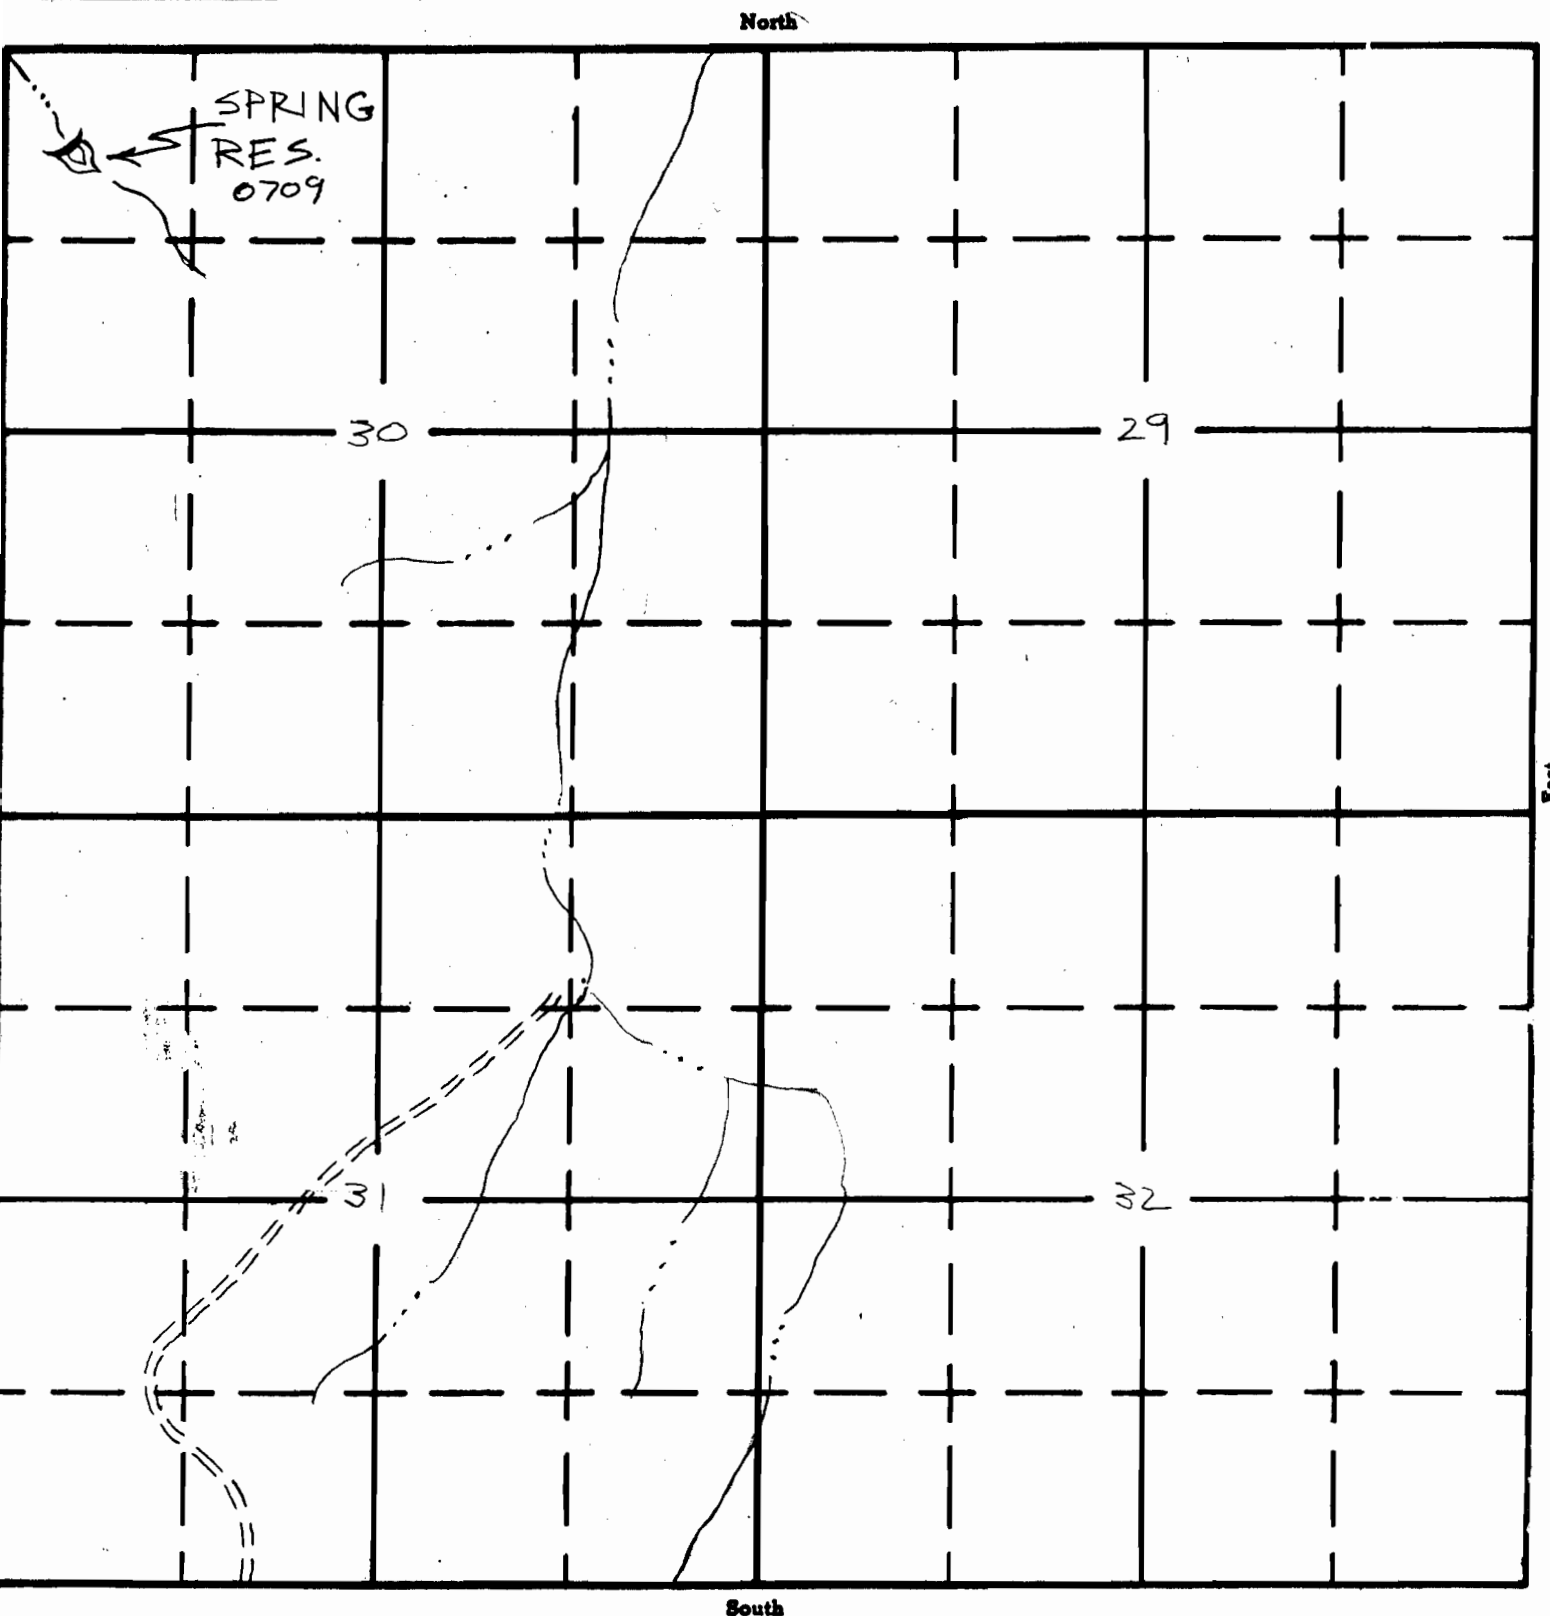

APPLICATION No. R-68873
R11080