

Form AI-187
March 1961

UNITED STATES
DEPARTMENT OF THE INTERIOR
BUREAU OF LAND MANAGEMENT

Application No. R-68874
Permit No. R11081


SECTION

Oregon State Water Filings

NW 1/4 NW 1/4
SEC 19

TOWNSHIP 22.5, RANGE 39 E, W. M.

North

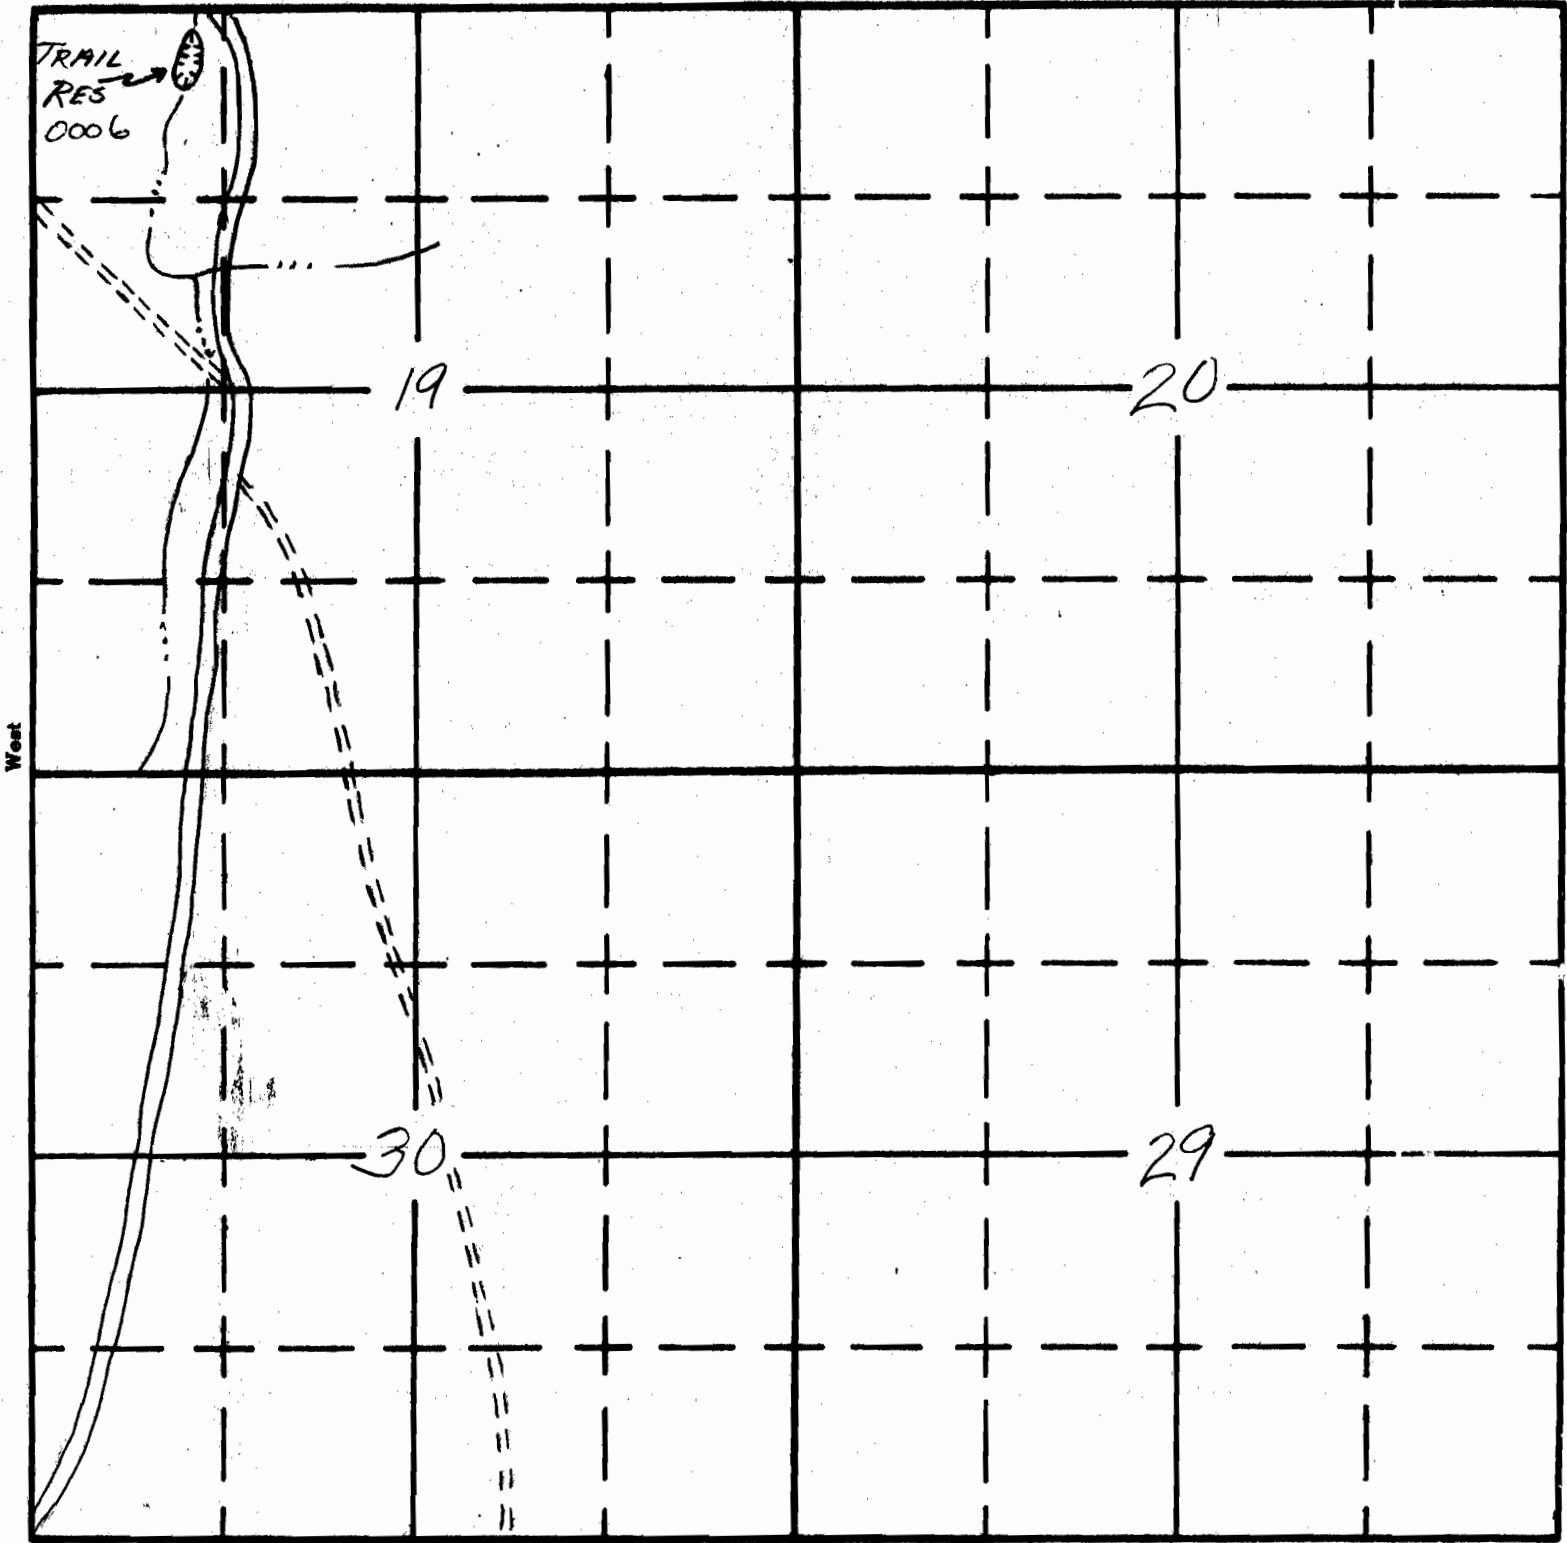

South

APPLICATION No. R-68874
PERMIT No.