


Form AI-187  
March 1961

UNITED STATES  
DEPARTMENT OF THE INTERIOR  
BUREAU OF LAND MANAGEMENT

SECTION

SE 1/4 NW 1/4  
Sec-1

**Oregon State Water Filings** *Long Haul*  
TOWNSHIP 23S, RANGE 40E, W. M. *Res. (4366)*

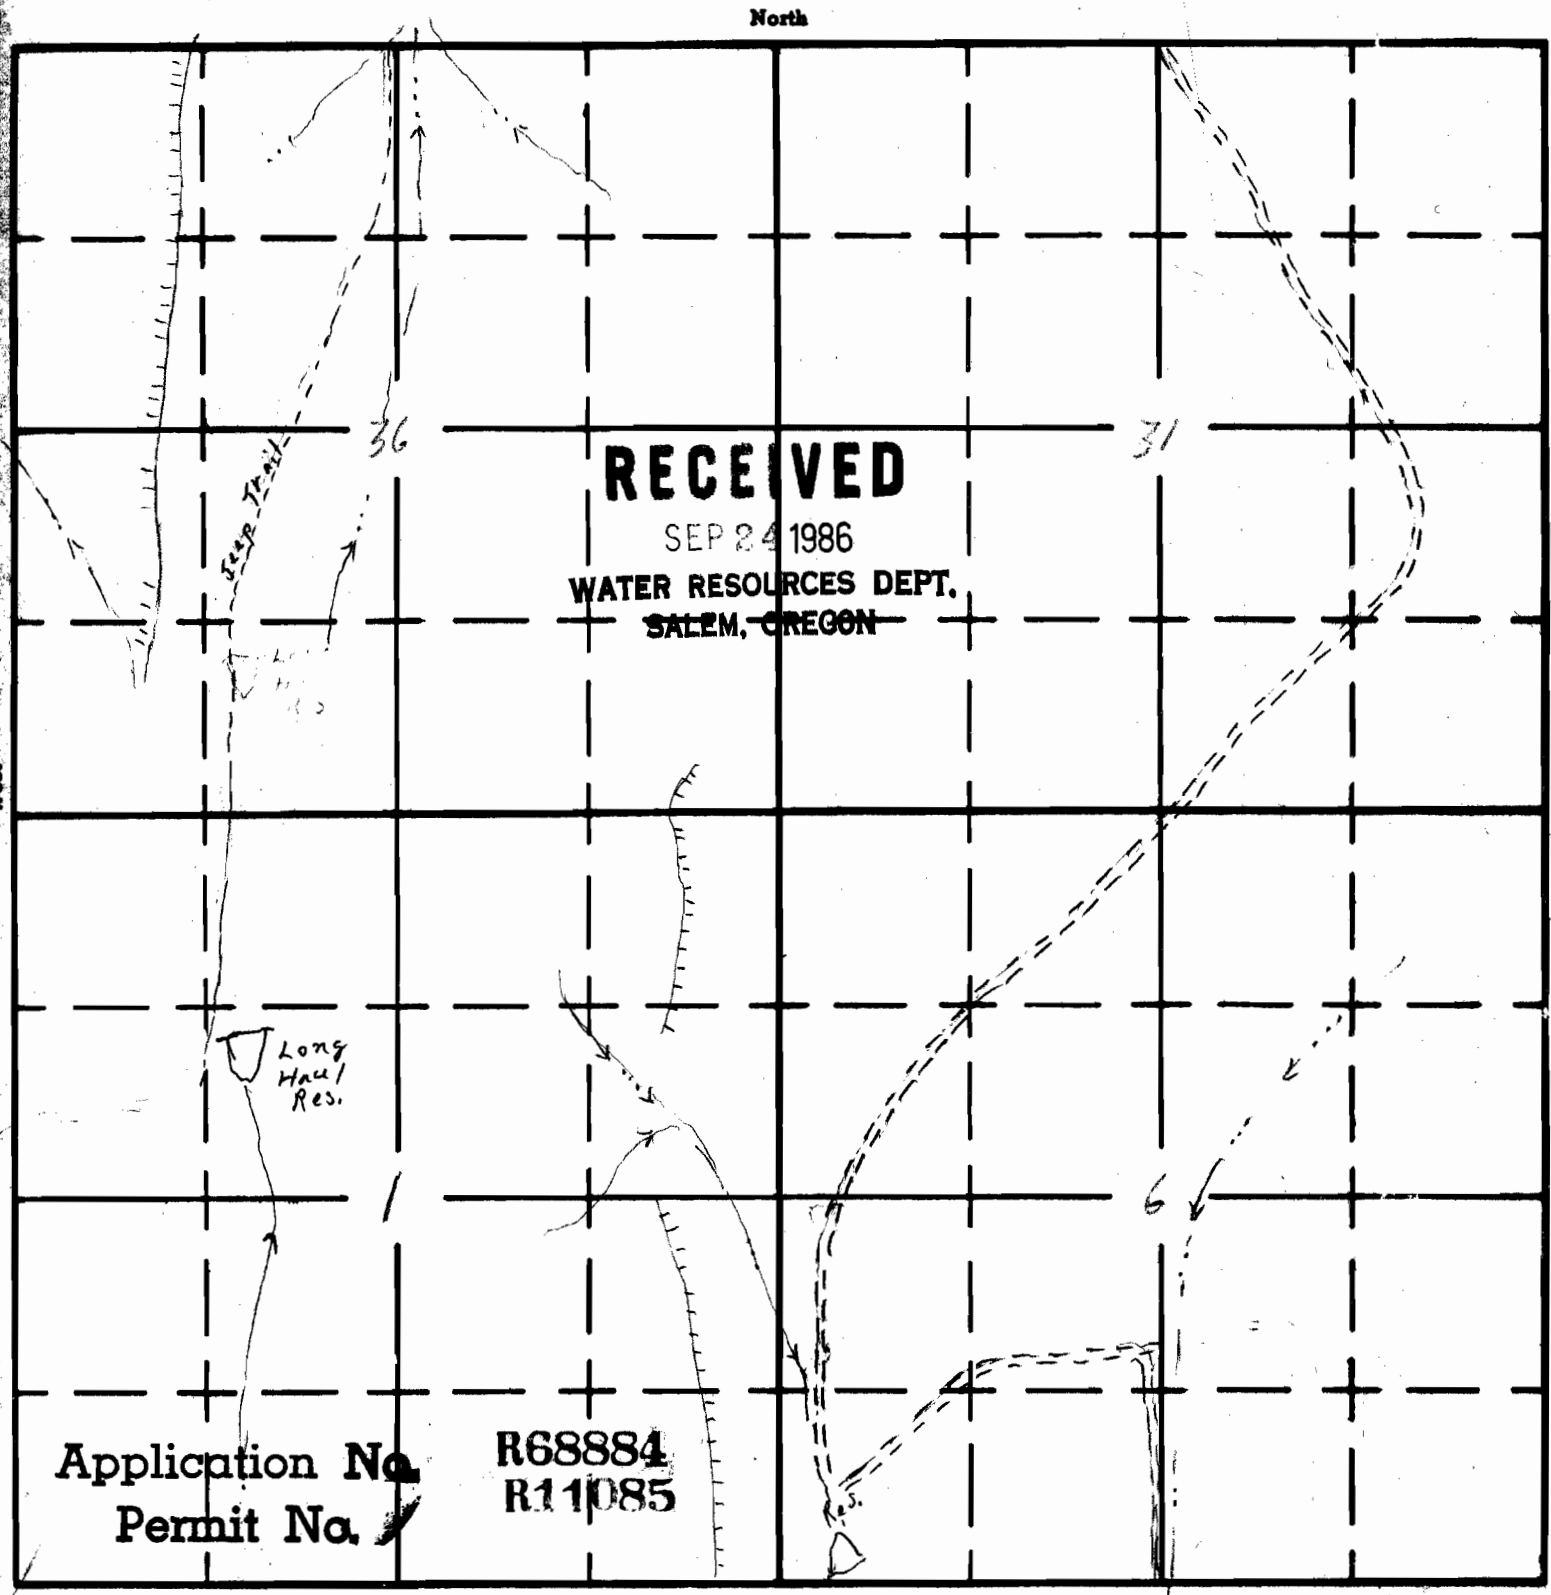

North

South

Application No. **R68884**  
Permit No. **R11085**

APPLICATION No.  
PERMIT No.