


SECTION

3

NE NE

TOWNSHIP 32 S, RANGE 32 3/4 E, W.M.

North

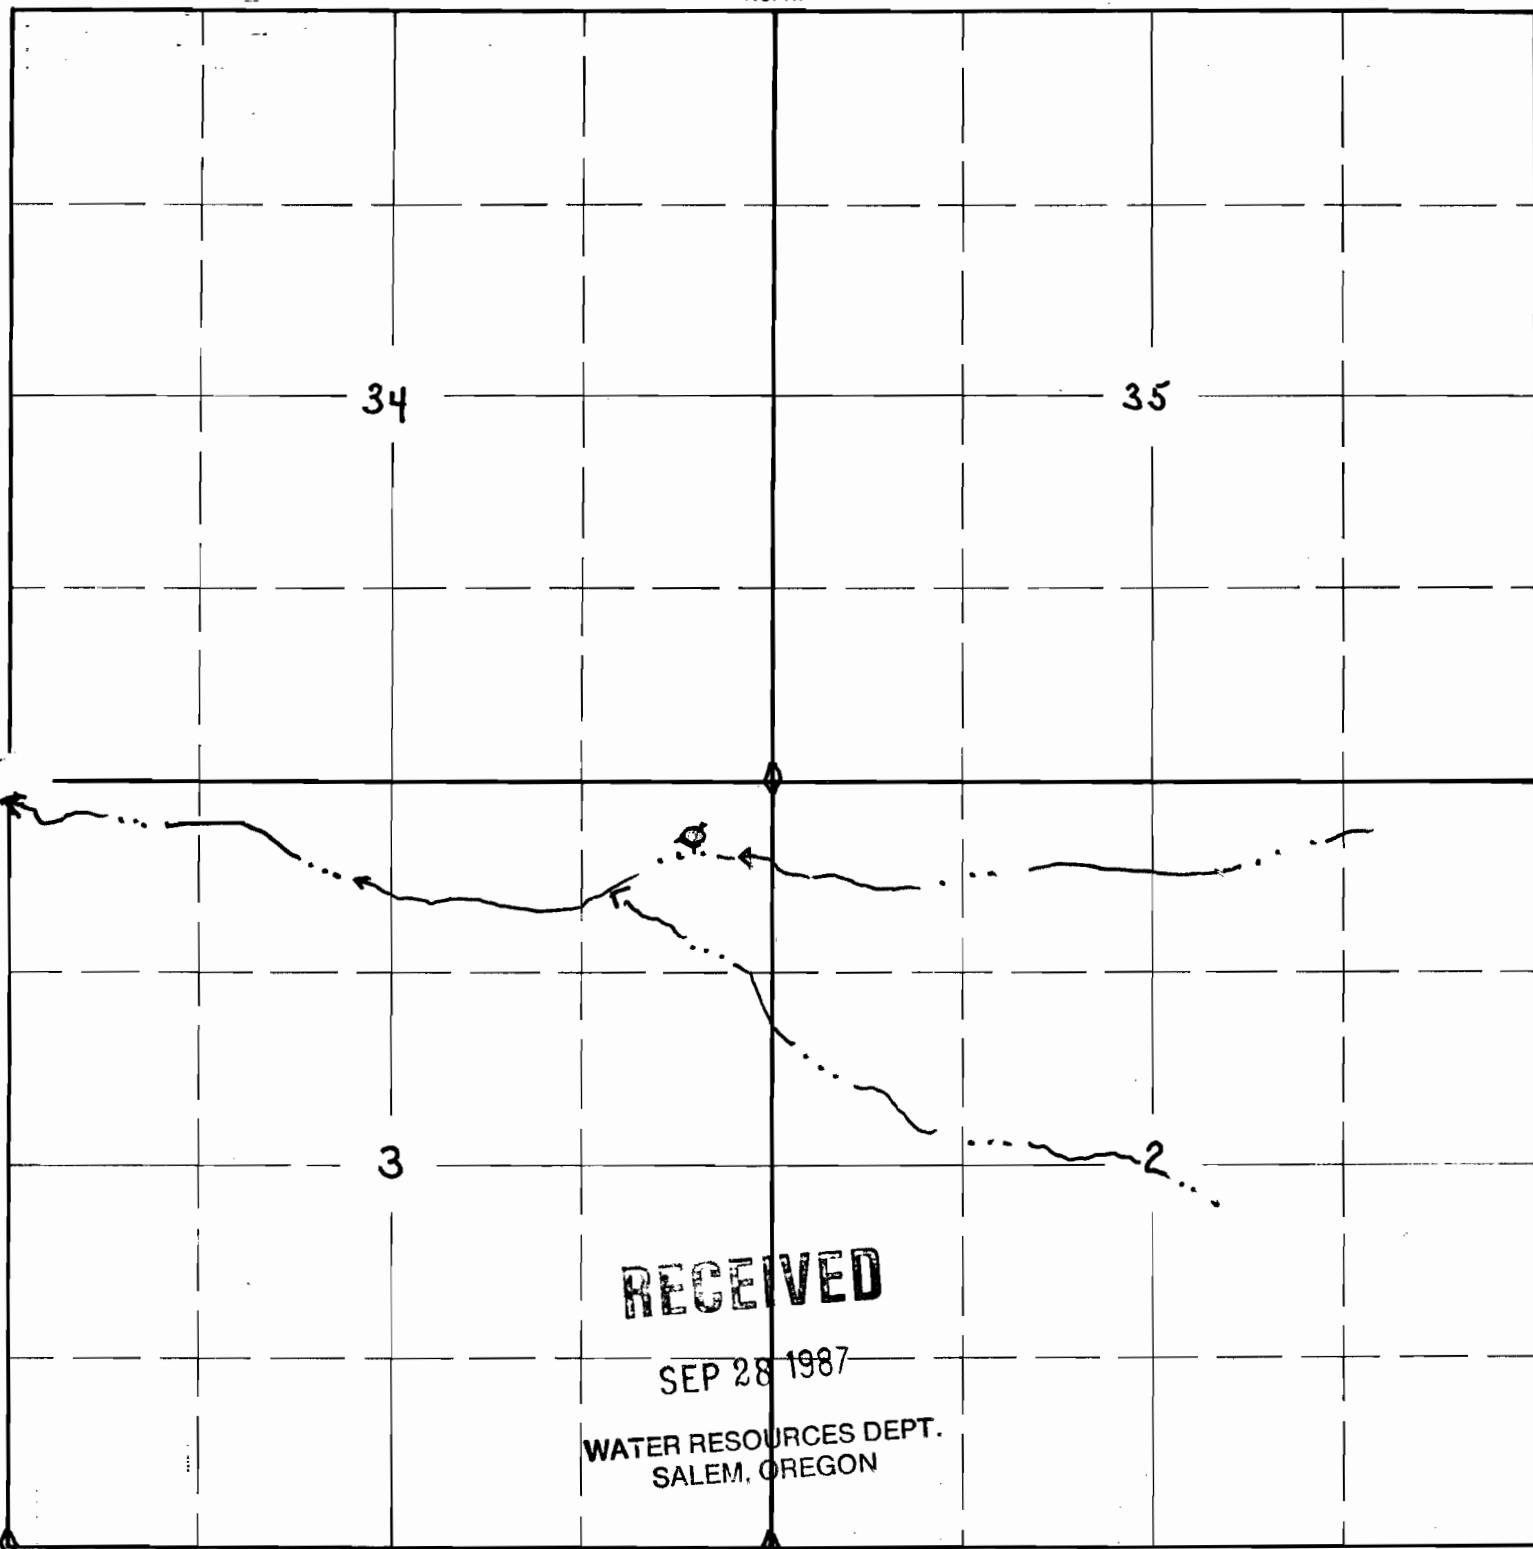

South

U.S. DEPARTMENT OF INTERIOR
BUREAU OF LAND MANAGEMENT
BURNS OREGON

Sagehen Seep Dugout
09-0541

LOCATION: 500 ft S and 400' W
from the NE corner of
Sec. 3

APPLICATION No.

R-69365

PERMIT No.

R11059

From USGS 7.5' Topog (McCoy Ridge)