


SECTION

16

NENE

TOWNSHIP 32 S , RANGE 32 1/2 E , W.M.

North

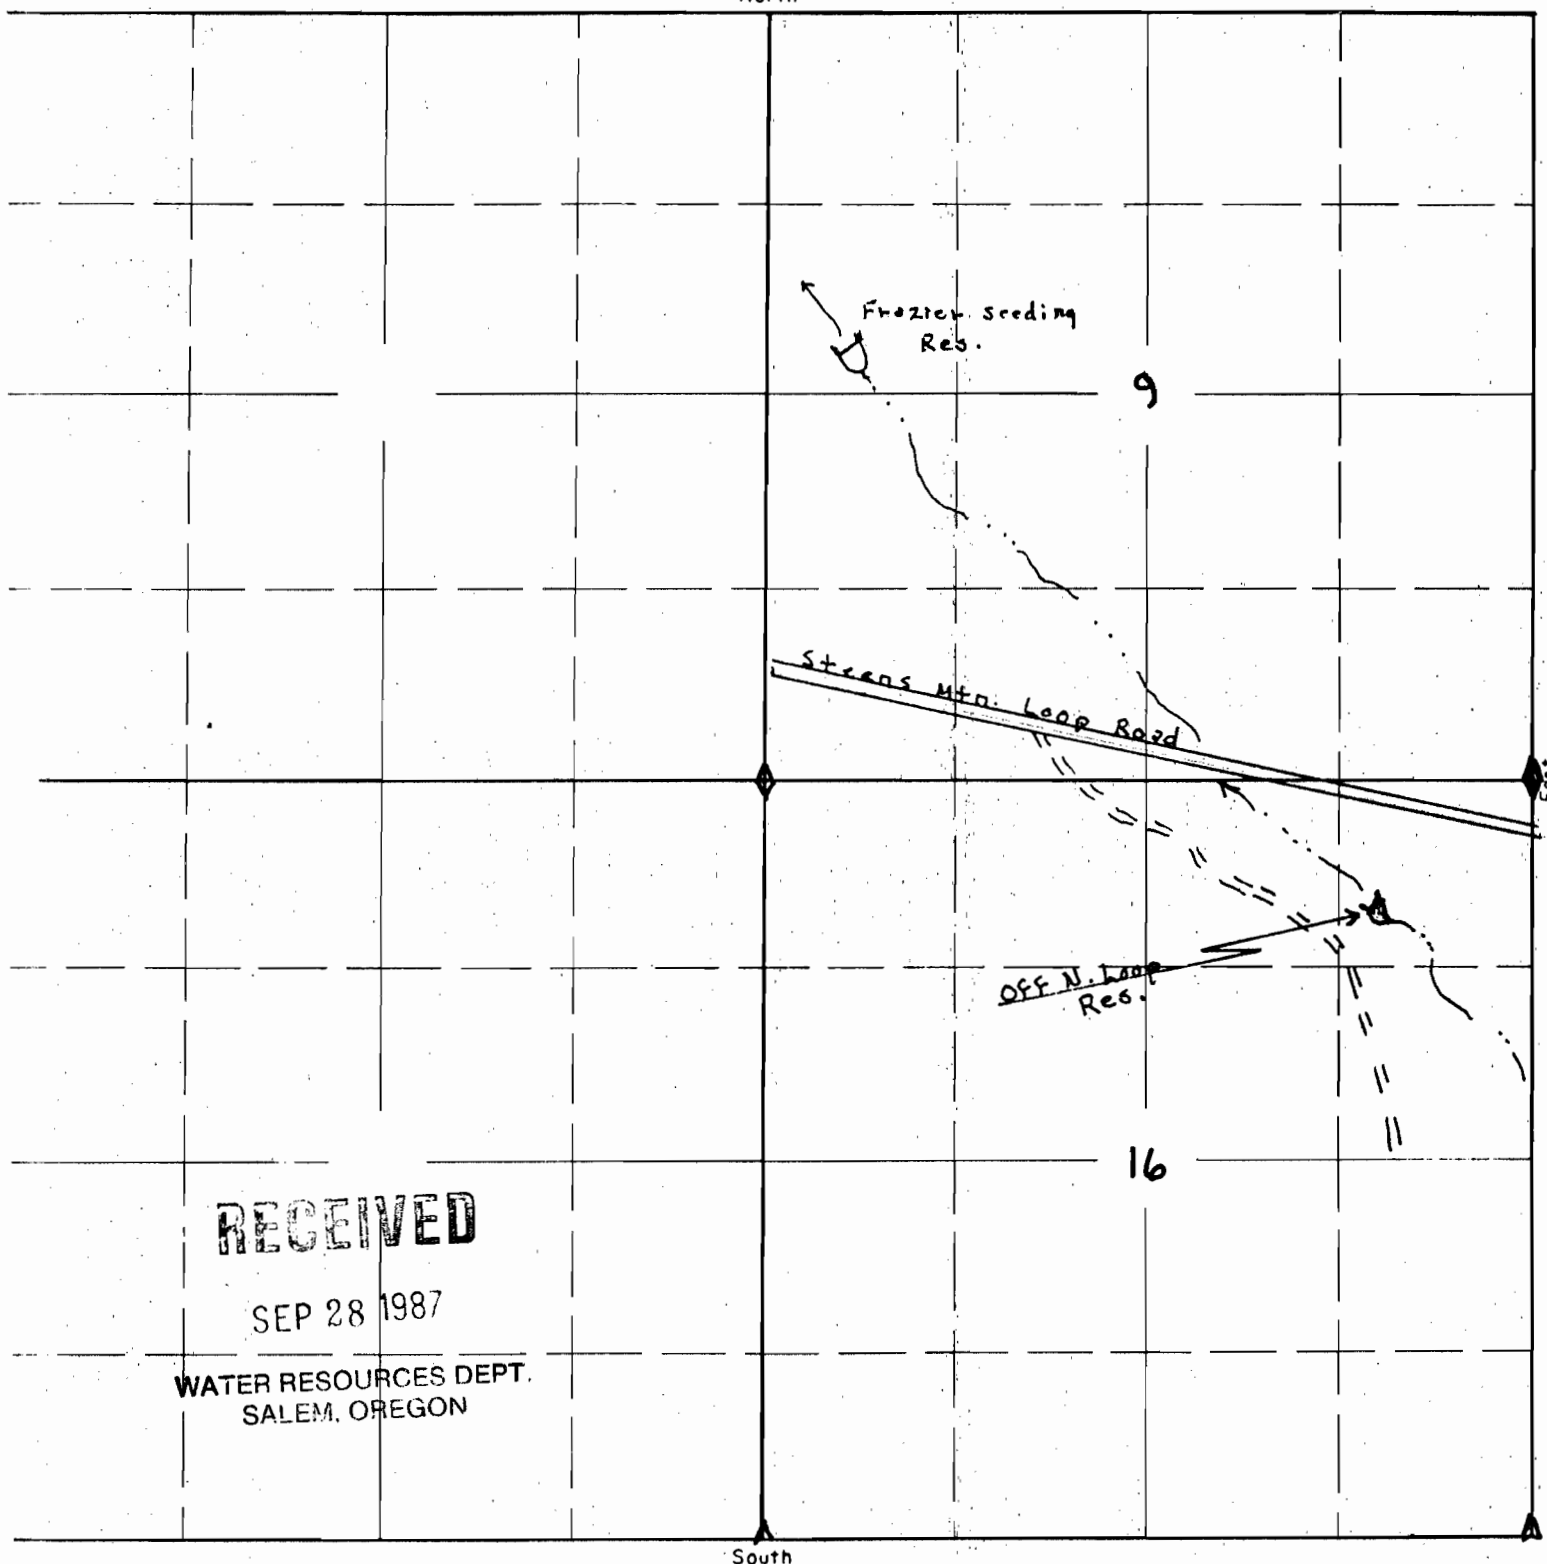

RECEIVED

SEP 28 1987

WATER RESOURCES DEPT.
SALEM, OREGON

South

U.S. DEPARTMENT OF INTERIOR
BUREAU OF LAND MANAGEMENT
Burns, Oregon

OFF-N.-Loop-Rd Res.

09-4973

LOCATION: 1040 Ft S and 1180' W
From the NE corner of
Sec. 16

APPLICATION No.

R-69367

PERMIT No.

R-11179

copy 9/3/87