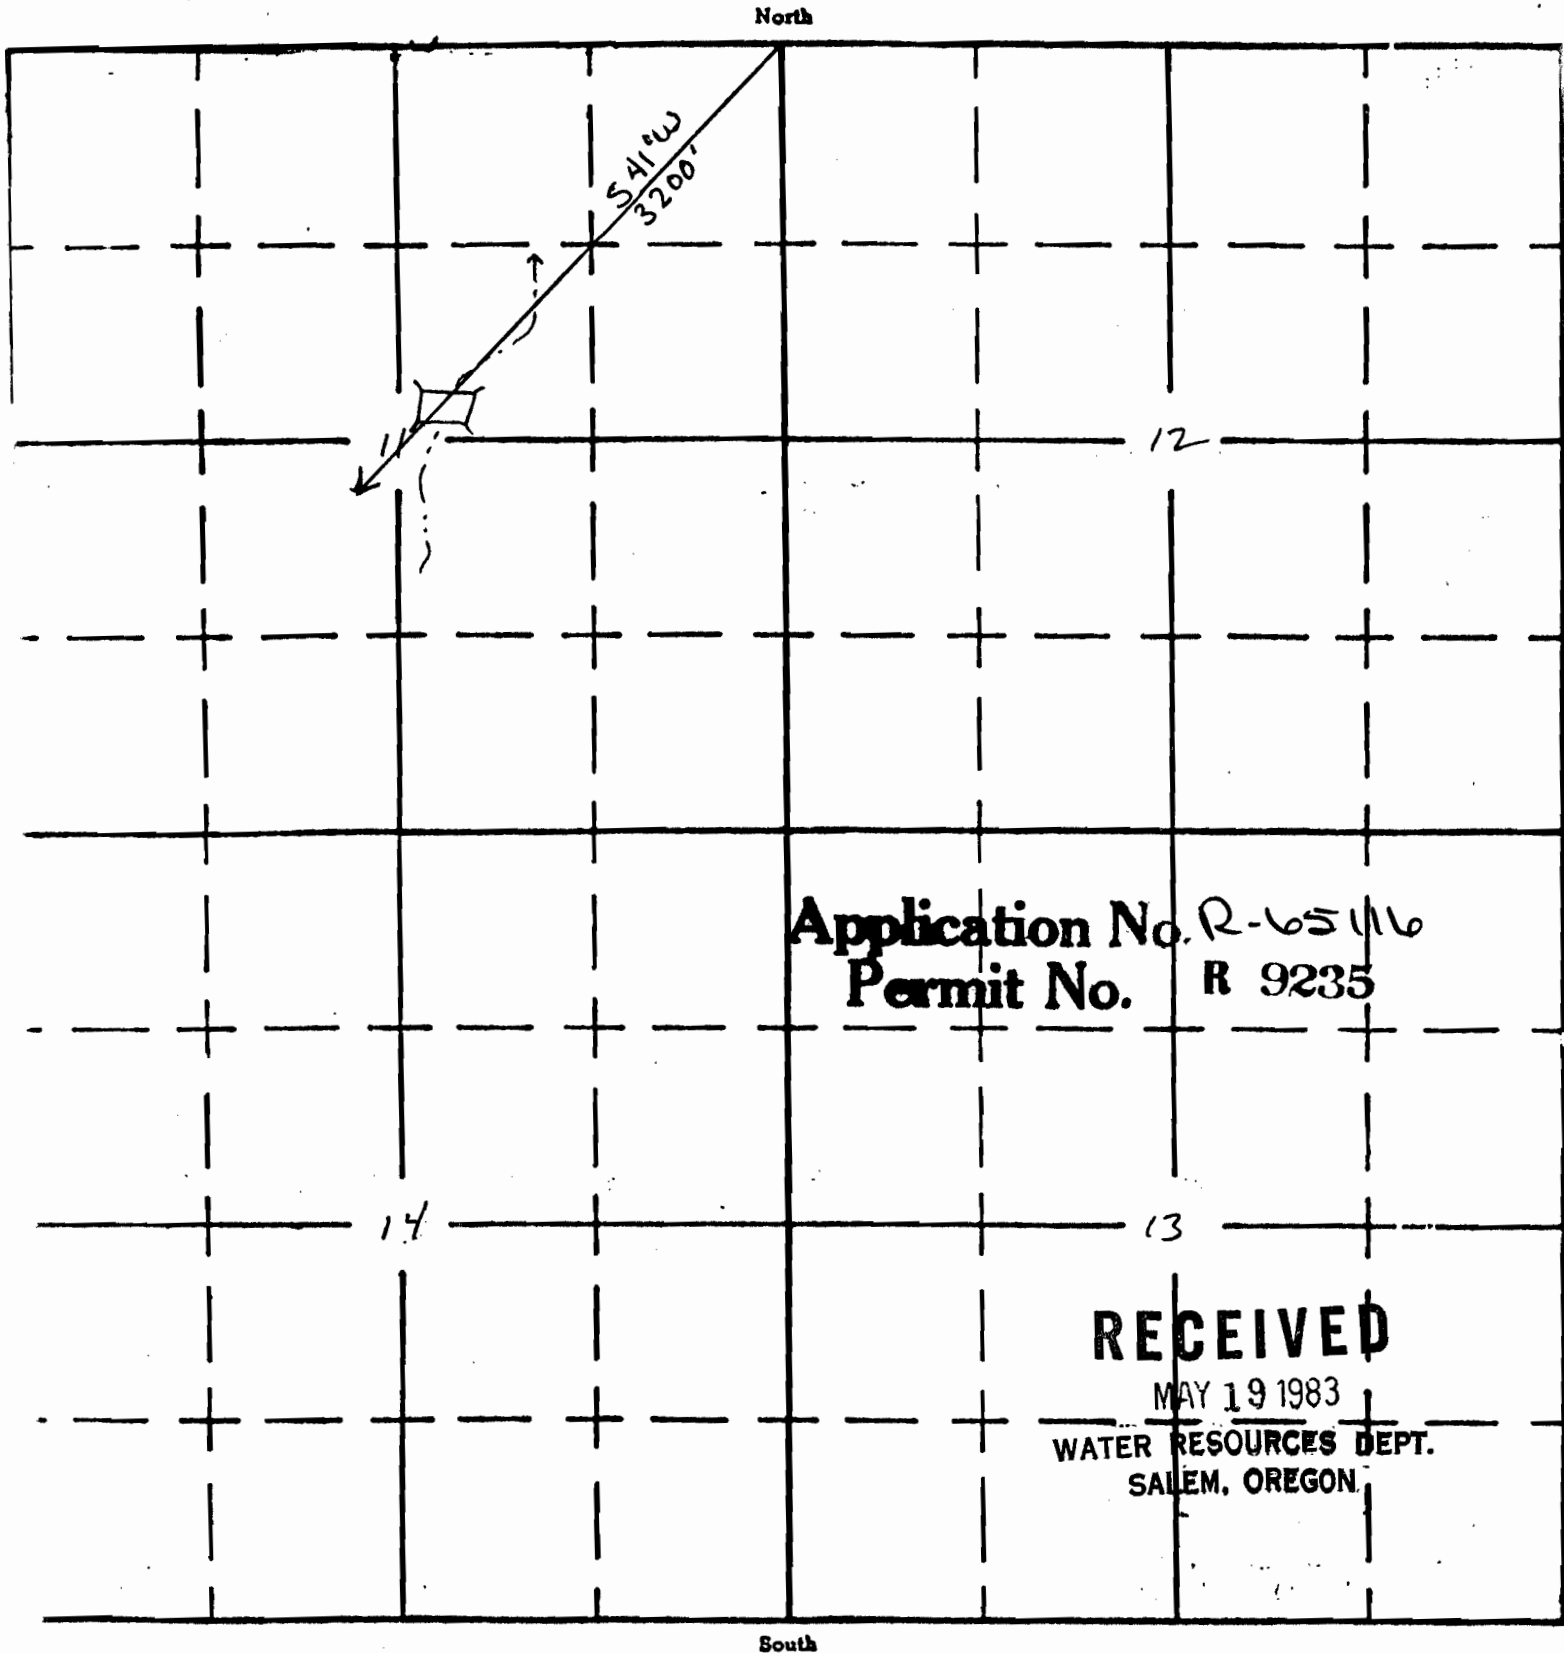


SECTION

11

Oregon State Water Filings

TOWNSHIP 41 S, RANGE 27 E, W. M.SW NEAPPLICATION No.
PERMIT No.