


T. 23 S., R. 12 W., W.M.

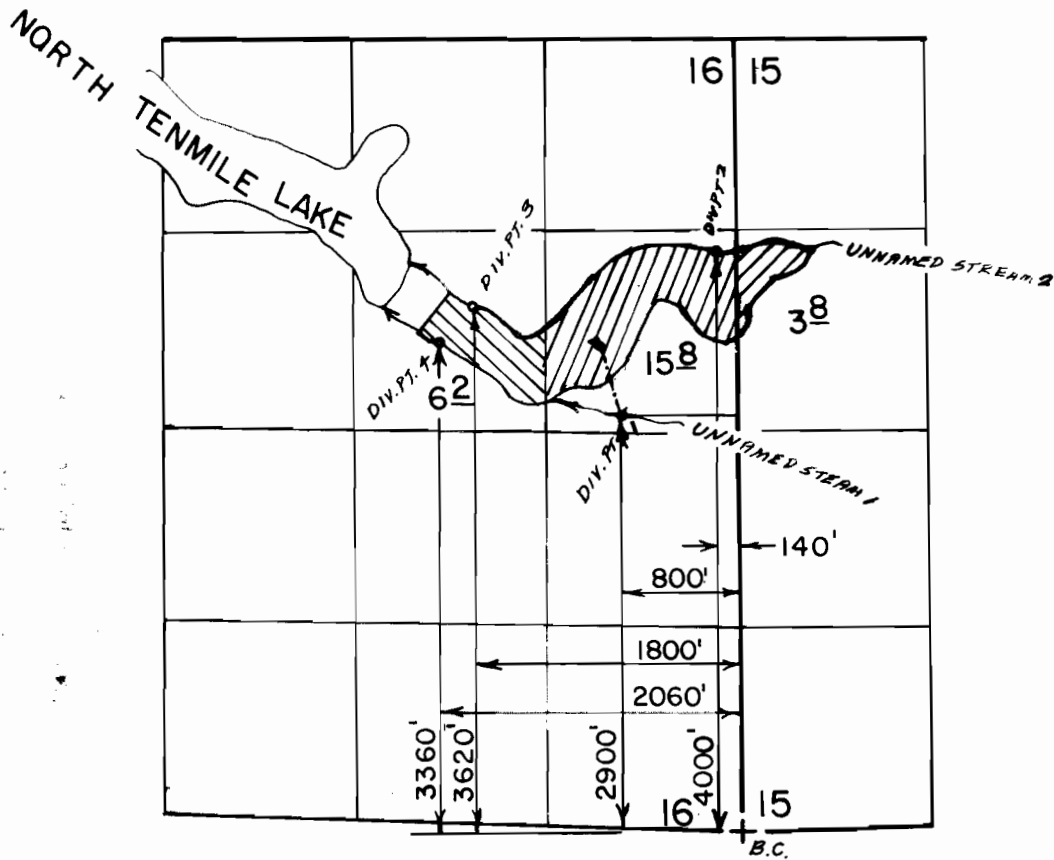

Scale 1" = 1320'

FINAL PROOF SURVEY
UNDER

-  DIV. PT. 2
-  DIV. PT. 3
-  DIV. PT. 4

Application No. ~~60899~~ Permit No. ~~46295~~...
IN NAME OF

.....P. J. MENEGAT.....

Surveyed FEB. 11, 1997., by S. DeHaas.....