


T. 3N. R. 29E.W.M.

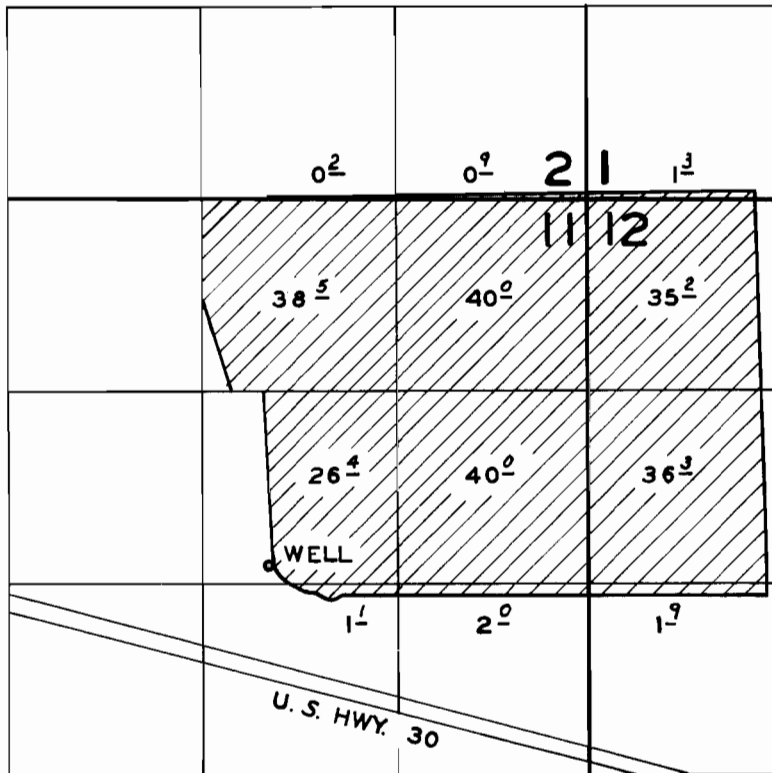

**FINAL PROOF SURVEY**  
UNDER

Application No. U 802 Permit No. U714  
IN NAME OF

**CLAUDE O. MEYERS**

Surveyed JULY 22 19 60, by *[Signature]*