

Form AI-187
March 1961

UNITED STATES
DEPARTMENT OF THE INTERIOR
BUREAU OF LAND MANAGEMENT

SECTION


21

Oregon State Water Filings

TOWNSHIP 10S, RANGE 42E, W. M.

North

06-353

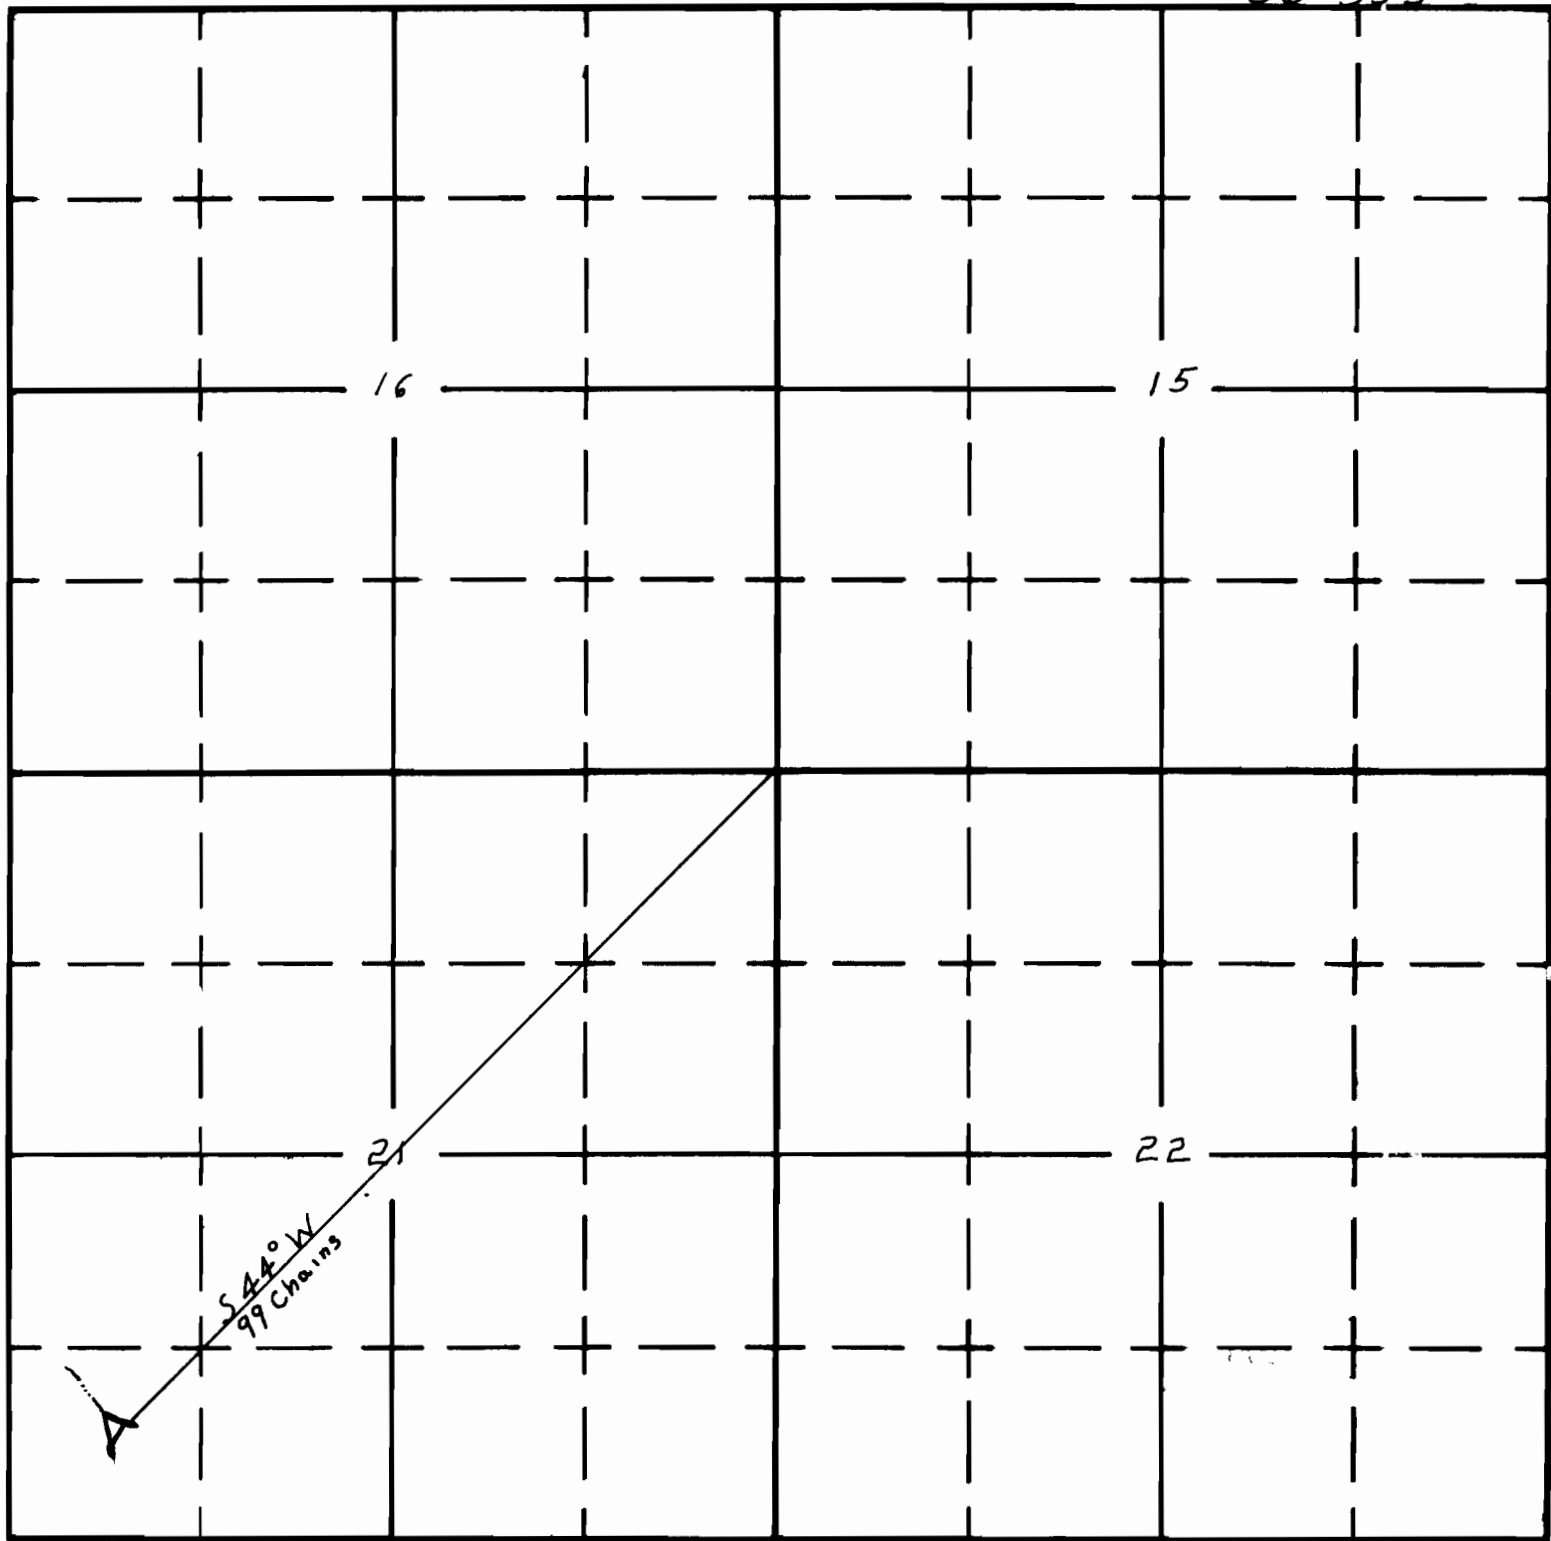

South

APPLICATION No. R-38407

PERMIT No. R4535