


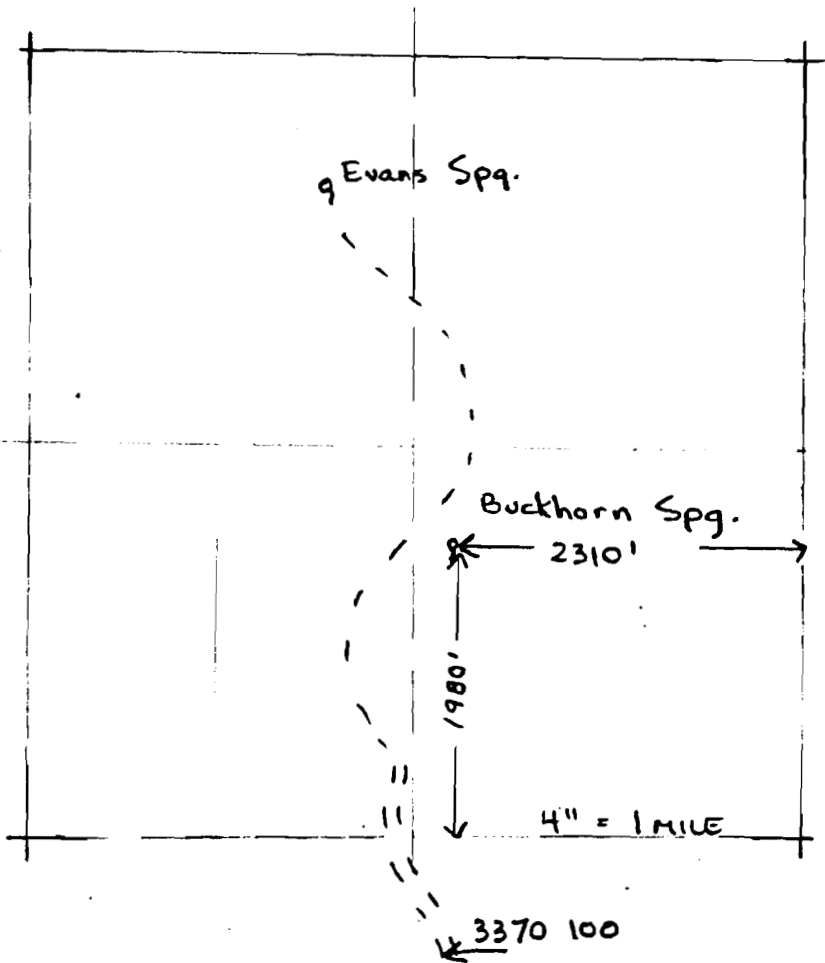

Buckhorn Spring

T. 13 S. R. 17 E. Sec. 21

RECEIVED

SEP 11 1981

WATER RESOURCES DEPT
SALEM, OREGON



T. Bedortha
Aug. 1981


Application No. 62733

Permit No. 48666

Spring development



0 10 20 30 40 FEET

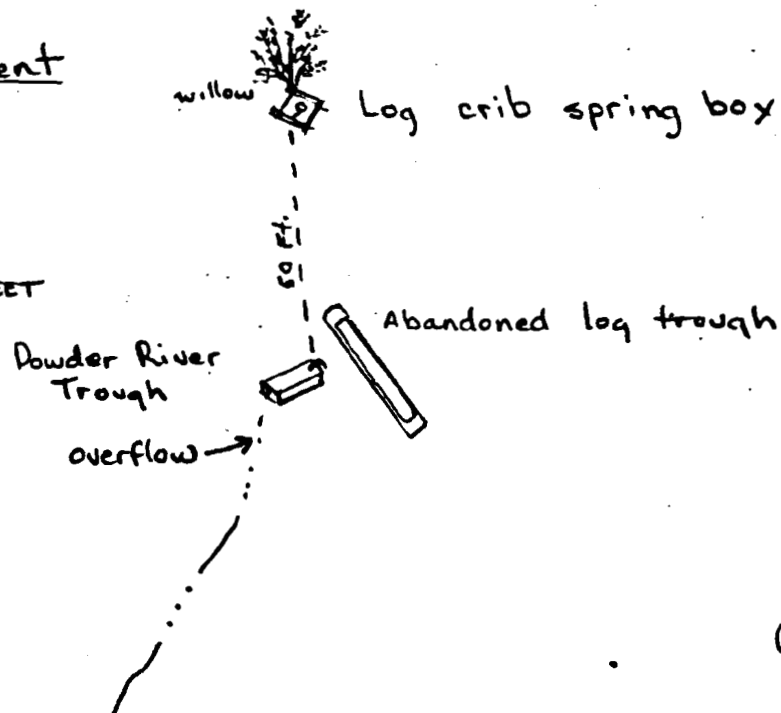

C-74769