


RECEIVED

SEP 11 1981

WATER RESOURCES DEPT
SALEM, OREGON

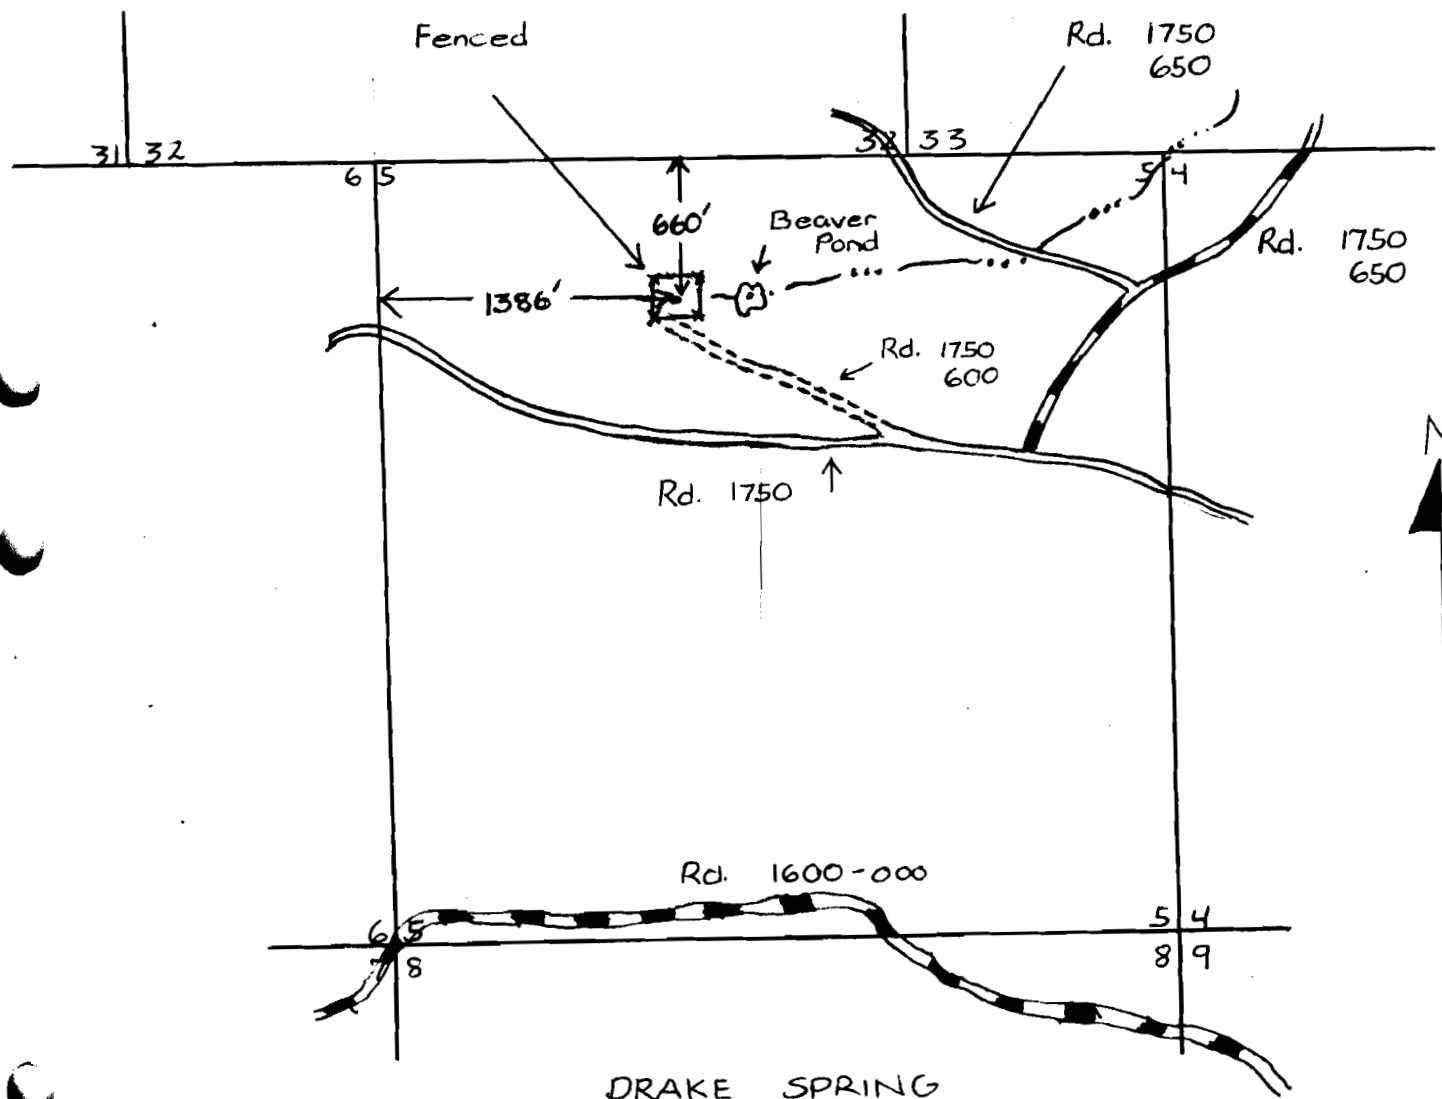

NE $\frac{1}{4}$, NW $\frac{1}{4}$, Sec 5, T18S, R20E, W.M.

Scale : 4 inches = 1 mile

Application No. 62738
Permit No. 48671

C-74771

48671