


RECEIVED

SEP 11 1981

WATER RESOURCES DEPT
SALEM, OREGON

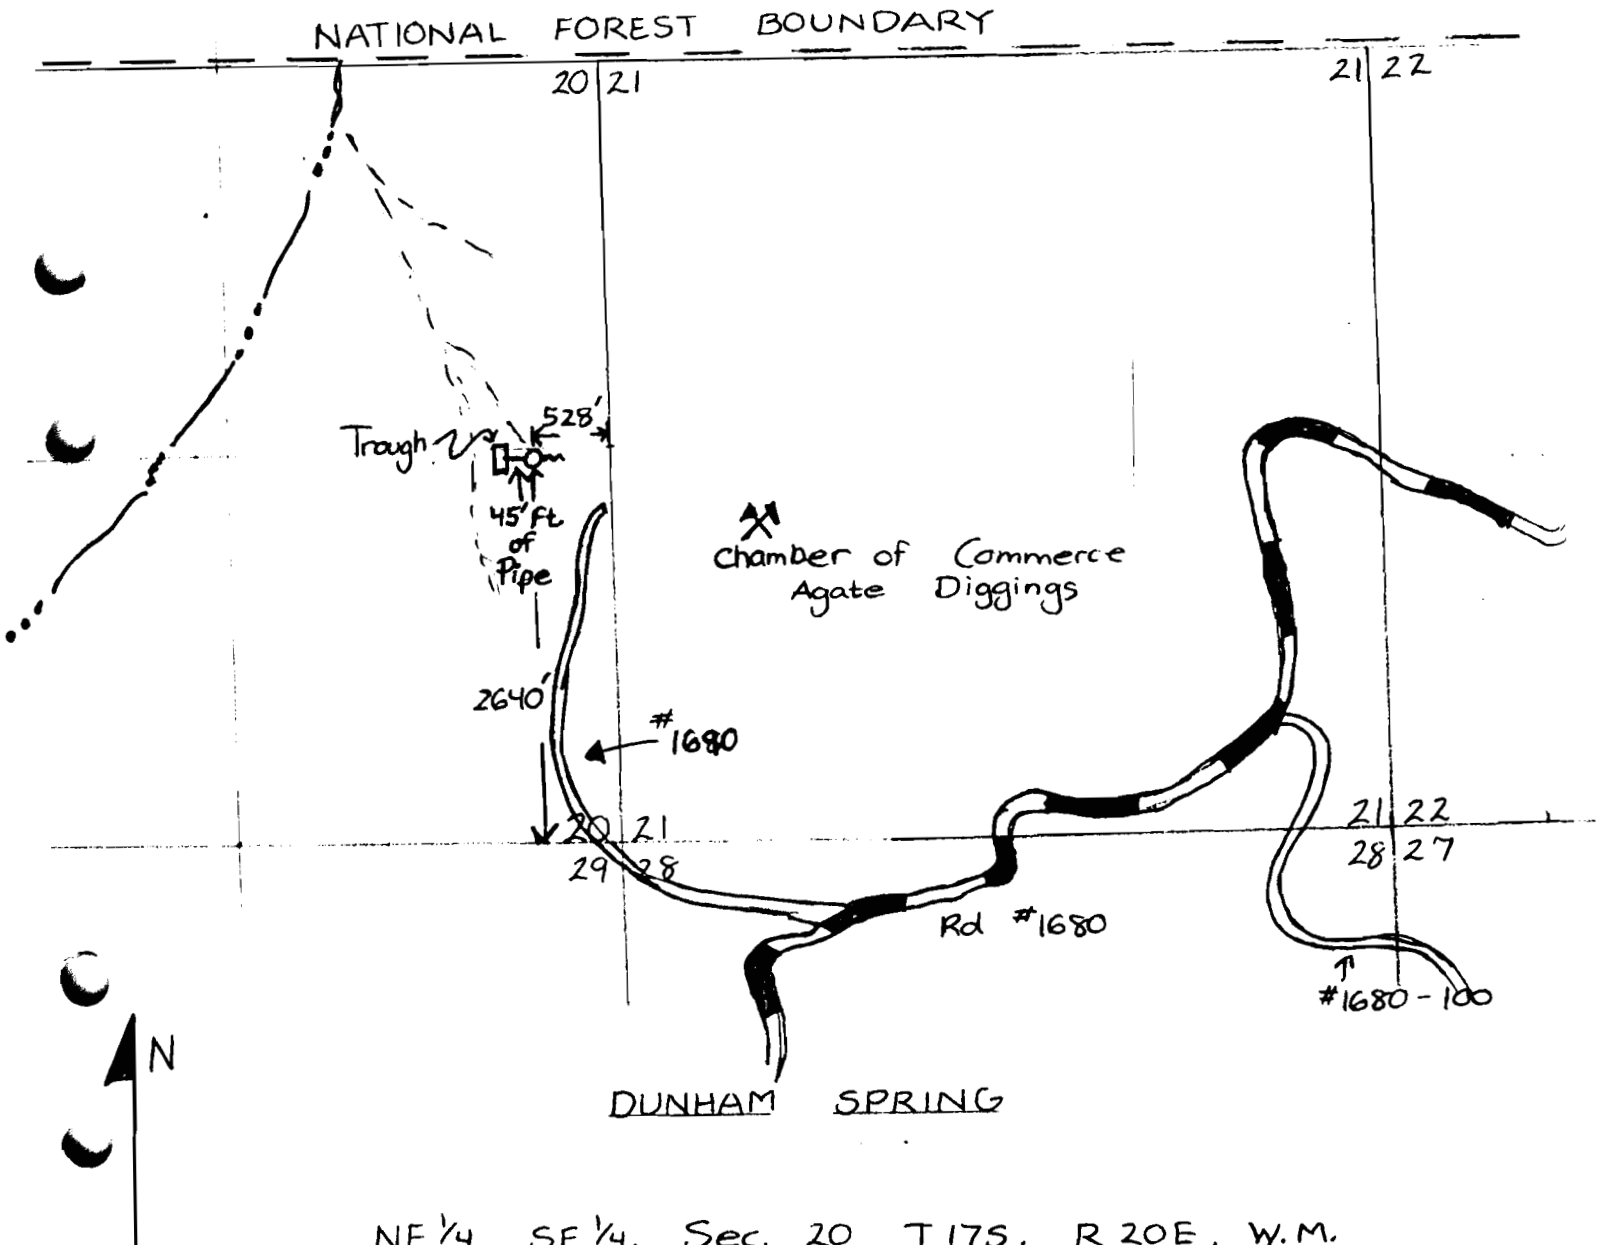

NE $\frac{1}{4}$, SE $\frac{1}{4}$, Sec. 20, T17S, R20E, W.M.

Scale: 4 inches = 1 mile

Application No. 62741

Permit No. 48674

C74772

48674