



Application No. 48218
Permit No. 48218

Williamson Riv. Misc.
666975

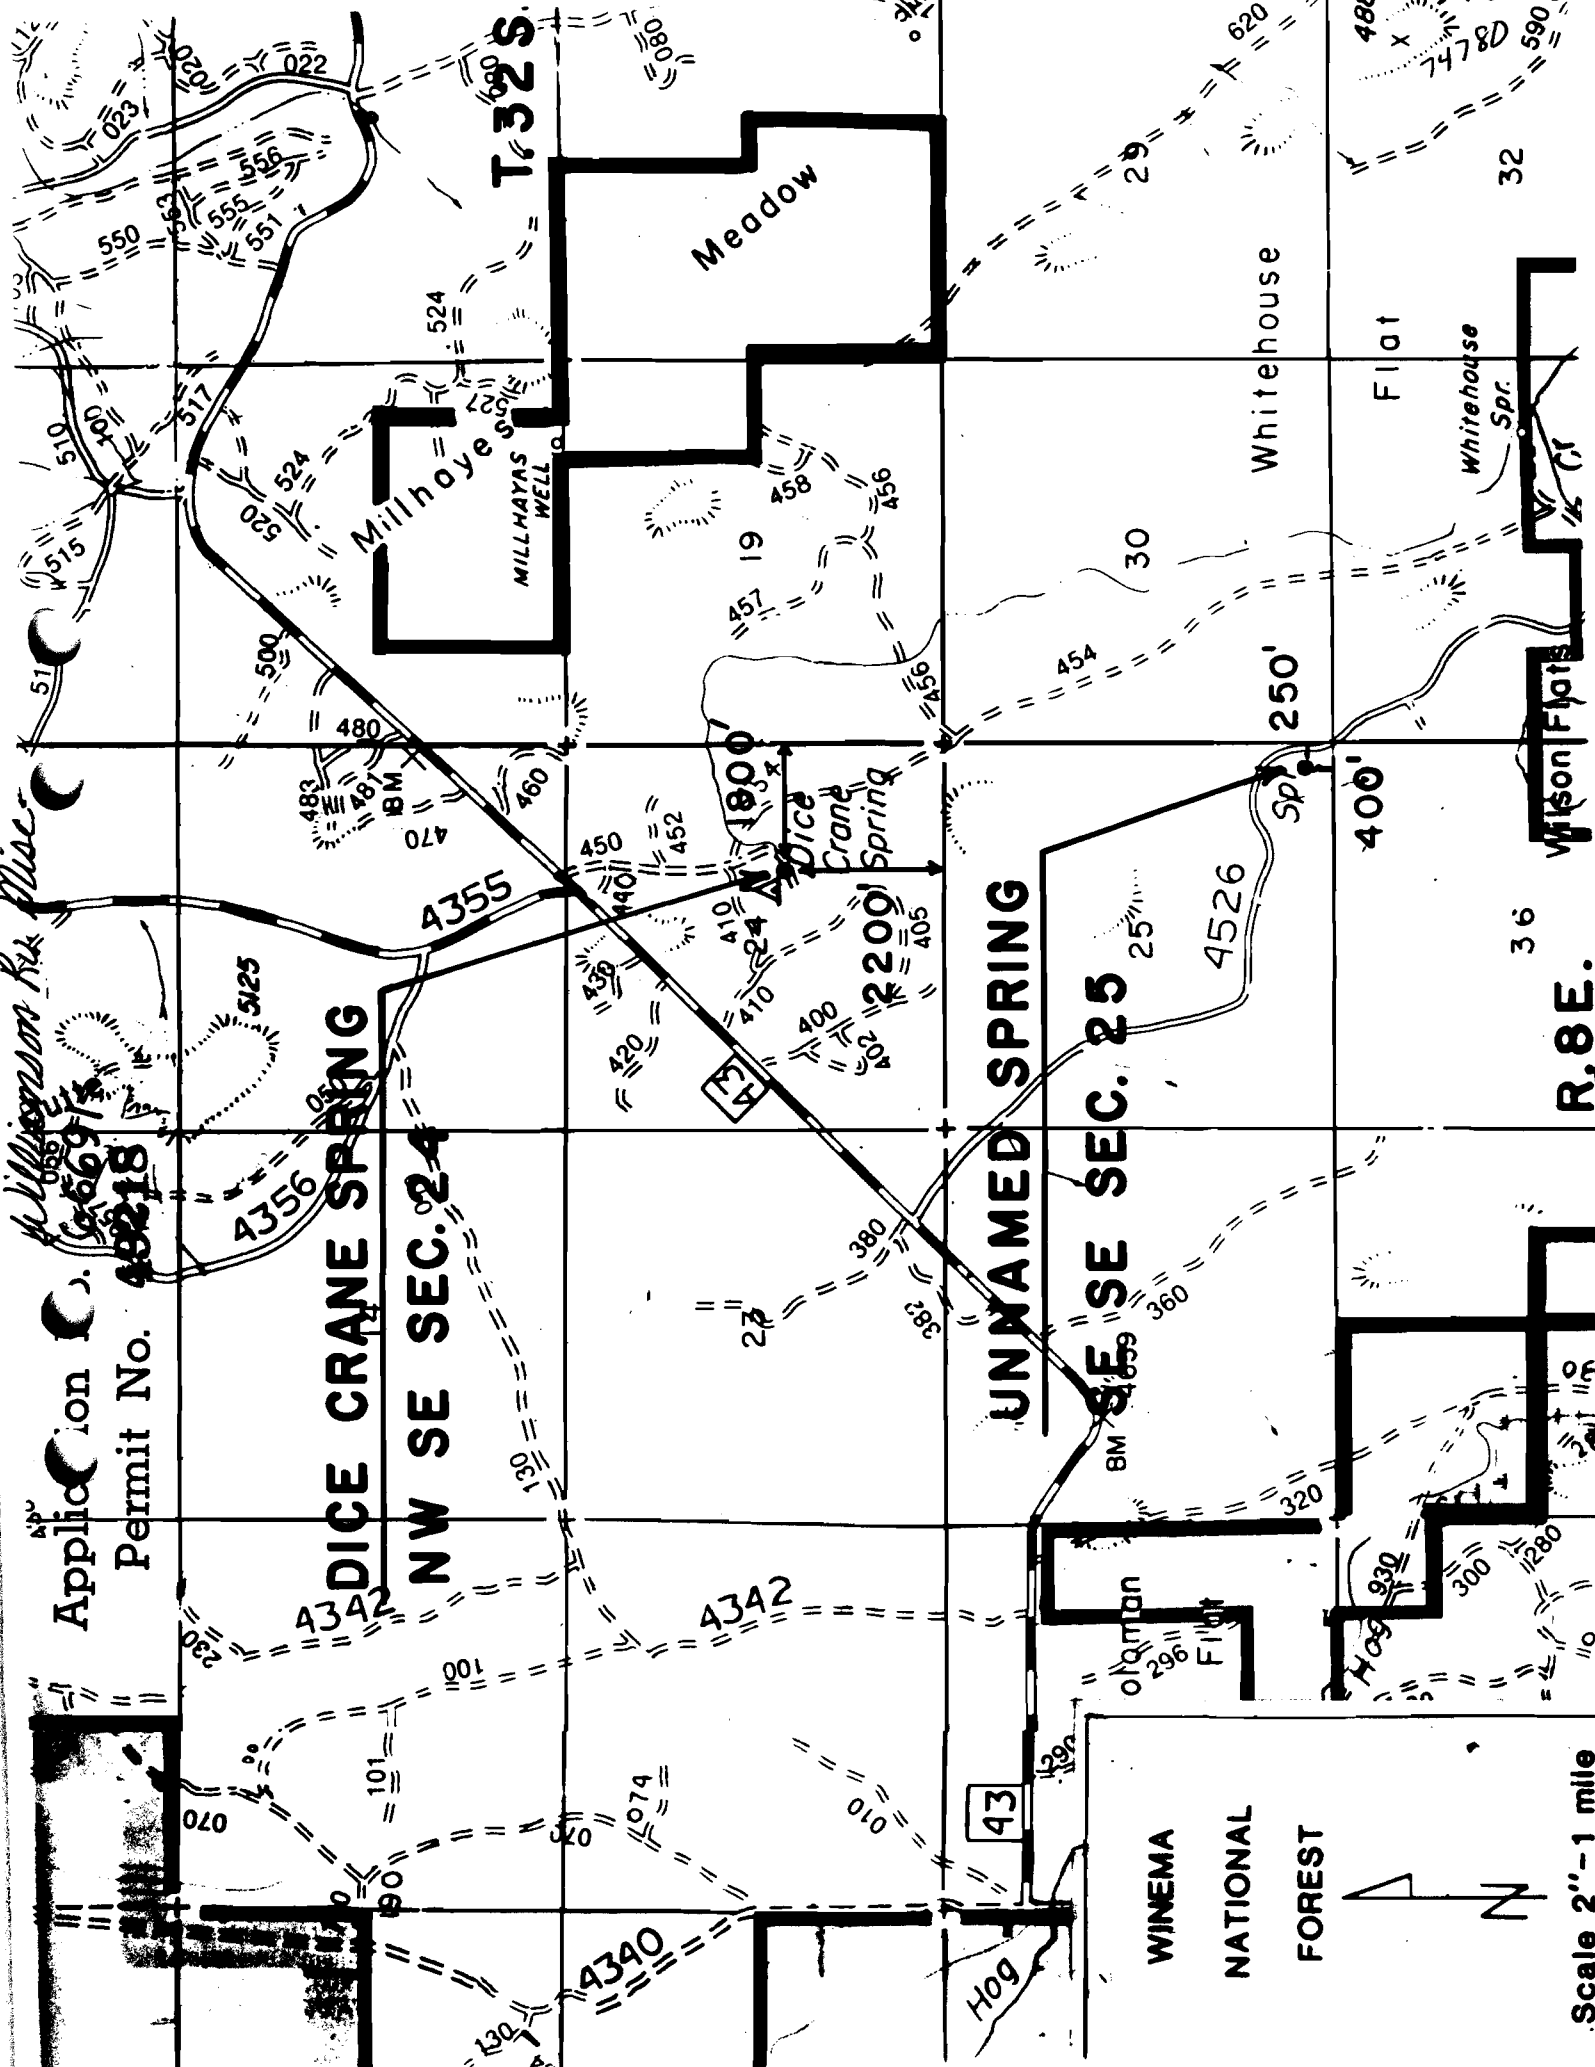

WINEMA
NATIONAL
FOREST

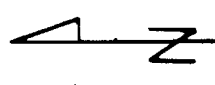

Scale 2" = 1 mile