



Post Spring

SCALE
4" = 1 mile

NORTH

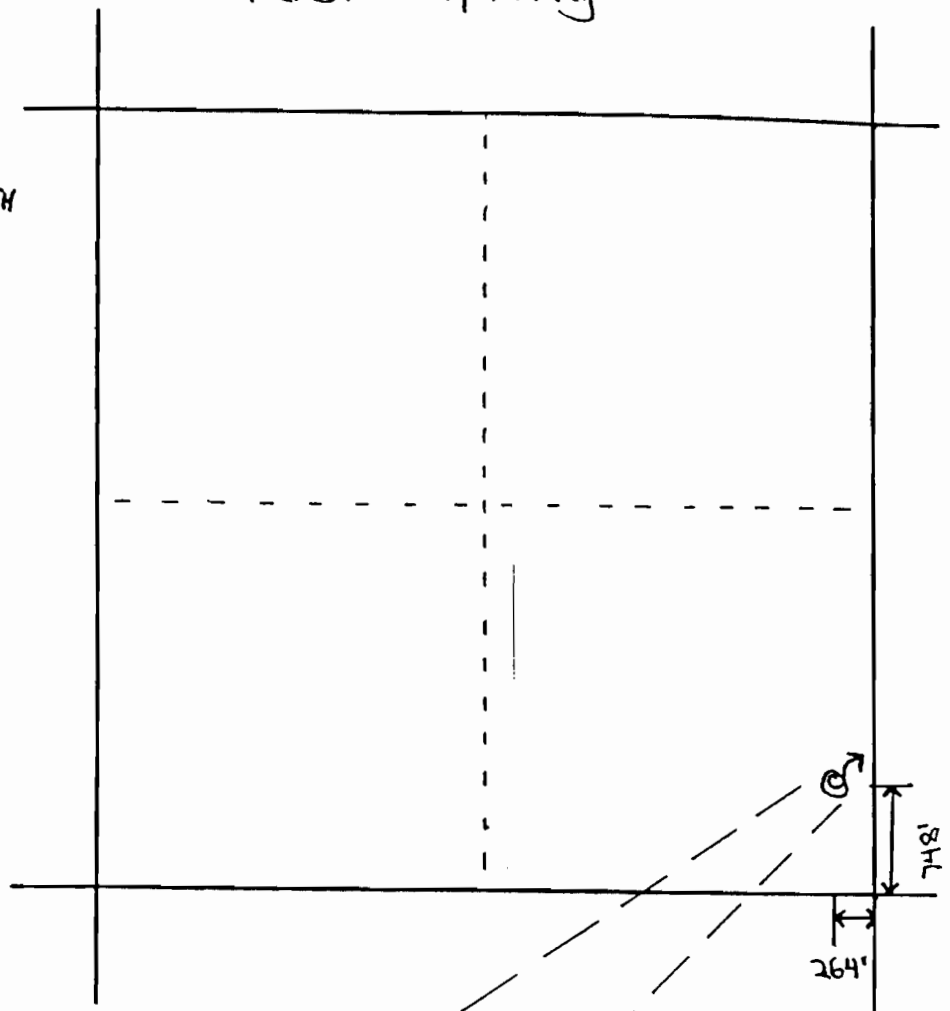

T17S, R18E, Sec 25, SE 1/4 SE 1/4, WM

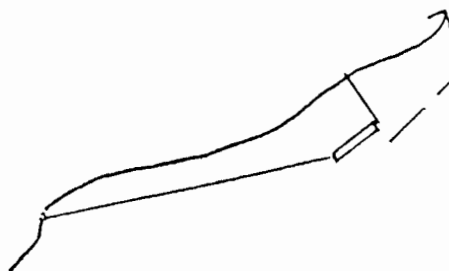

Scale
1" = 40'

Application No. 68173
Permit No. 48960

RECEIVED


SEP 6 1984

WATER RESOURCES DEPT
SALEM, OREGON

Trail Spring

SCALE
4" = 1 mile

NORTH

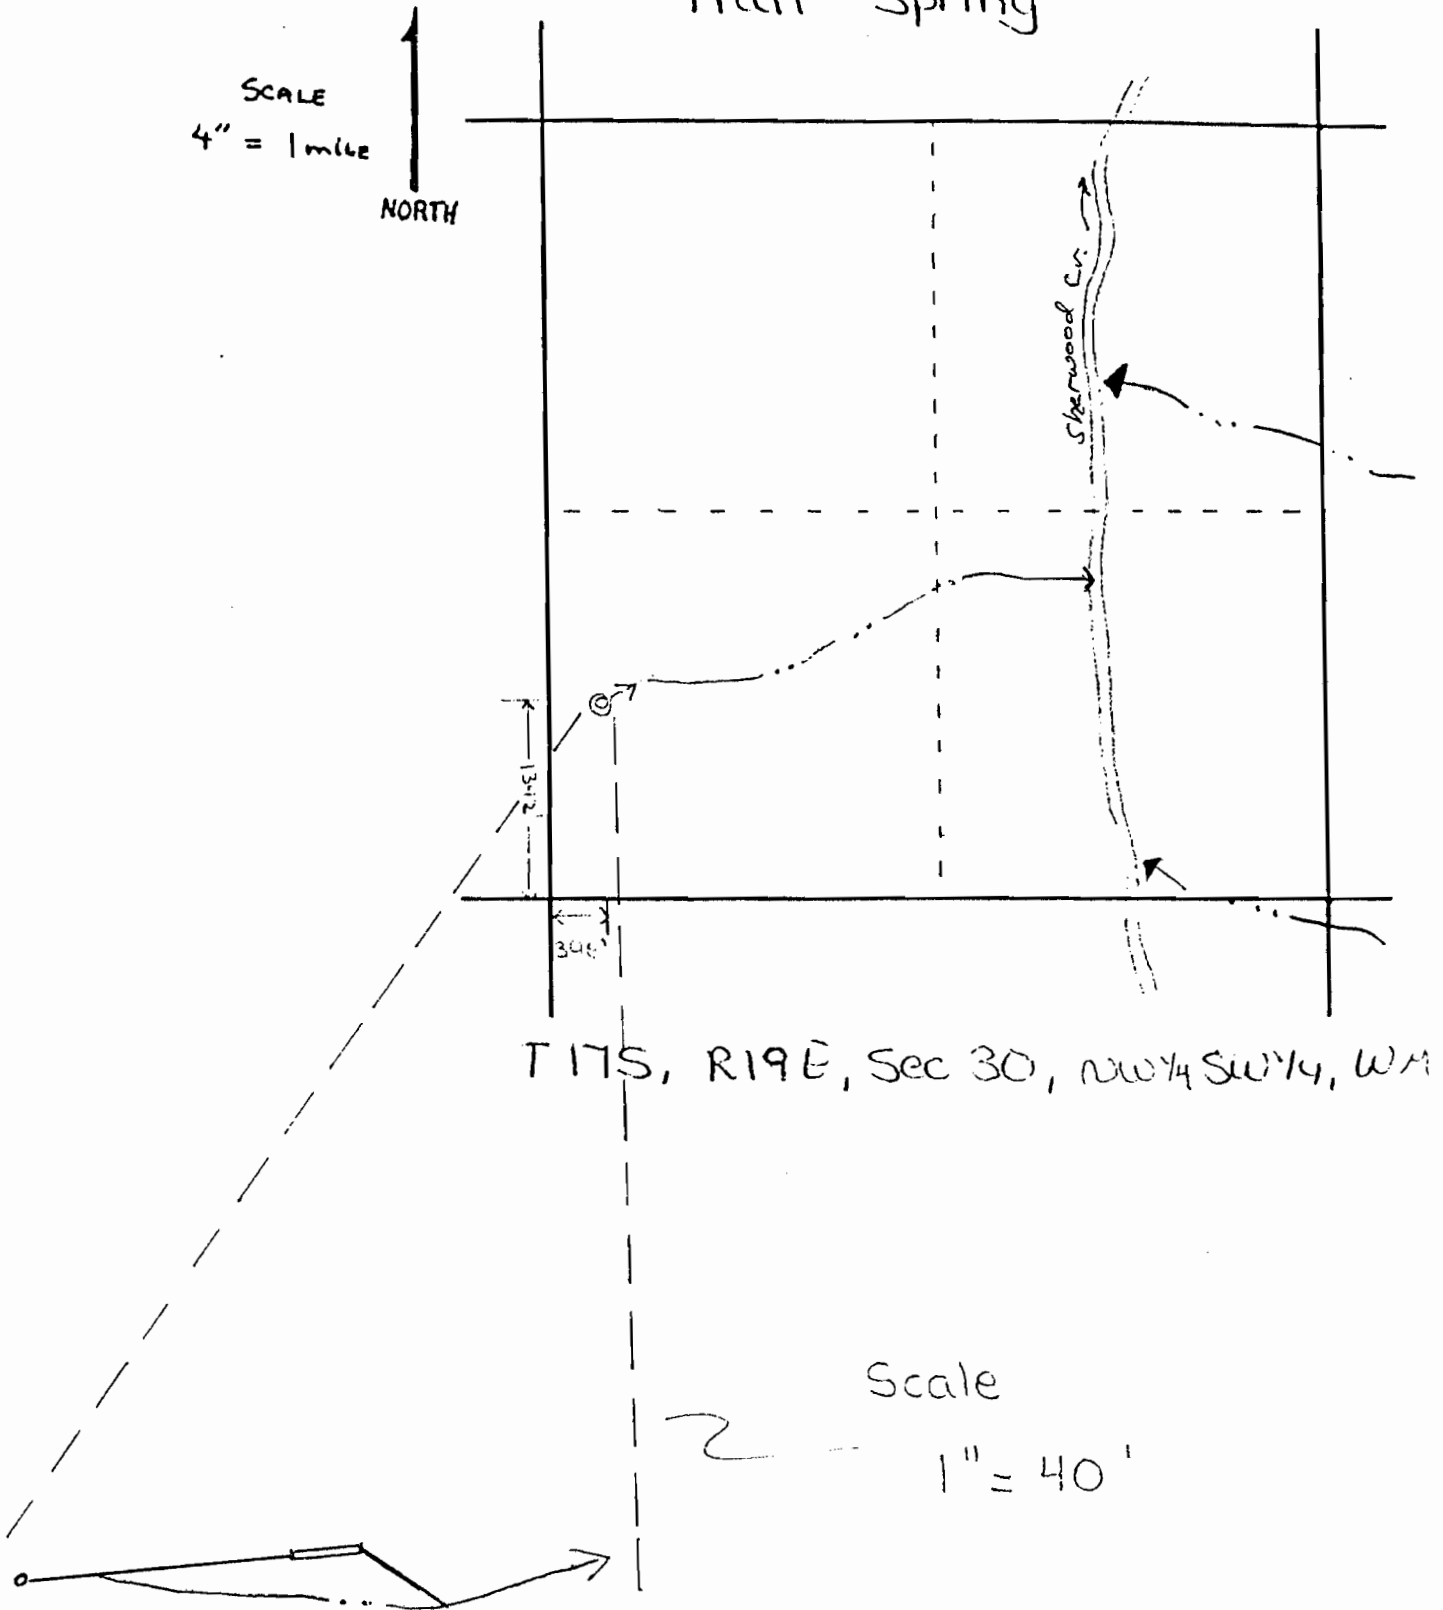

T 17S, R 19E, Sec 30, NW 1/4 SW 1/4, W 1/4

Scale

1" = 40'

Application No. 68173
Permit No. 48960

RECEIVED

SEP 6 1984

WATER RESOURCES DEPT
SALEM, OREGON