

Application No. KL0395

UNITED STATES

Permit No. 1041189

DEPARTMENT OF THE INTERIOR

BUREAU OF LAND MANAGEMENT

SECTION

11


Oregon State Water Filings

SW 1/4 NE 1/4

TOWNSHIP 18^s, RANGE 39^e, W. M.

North

Big Indian

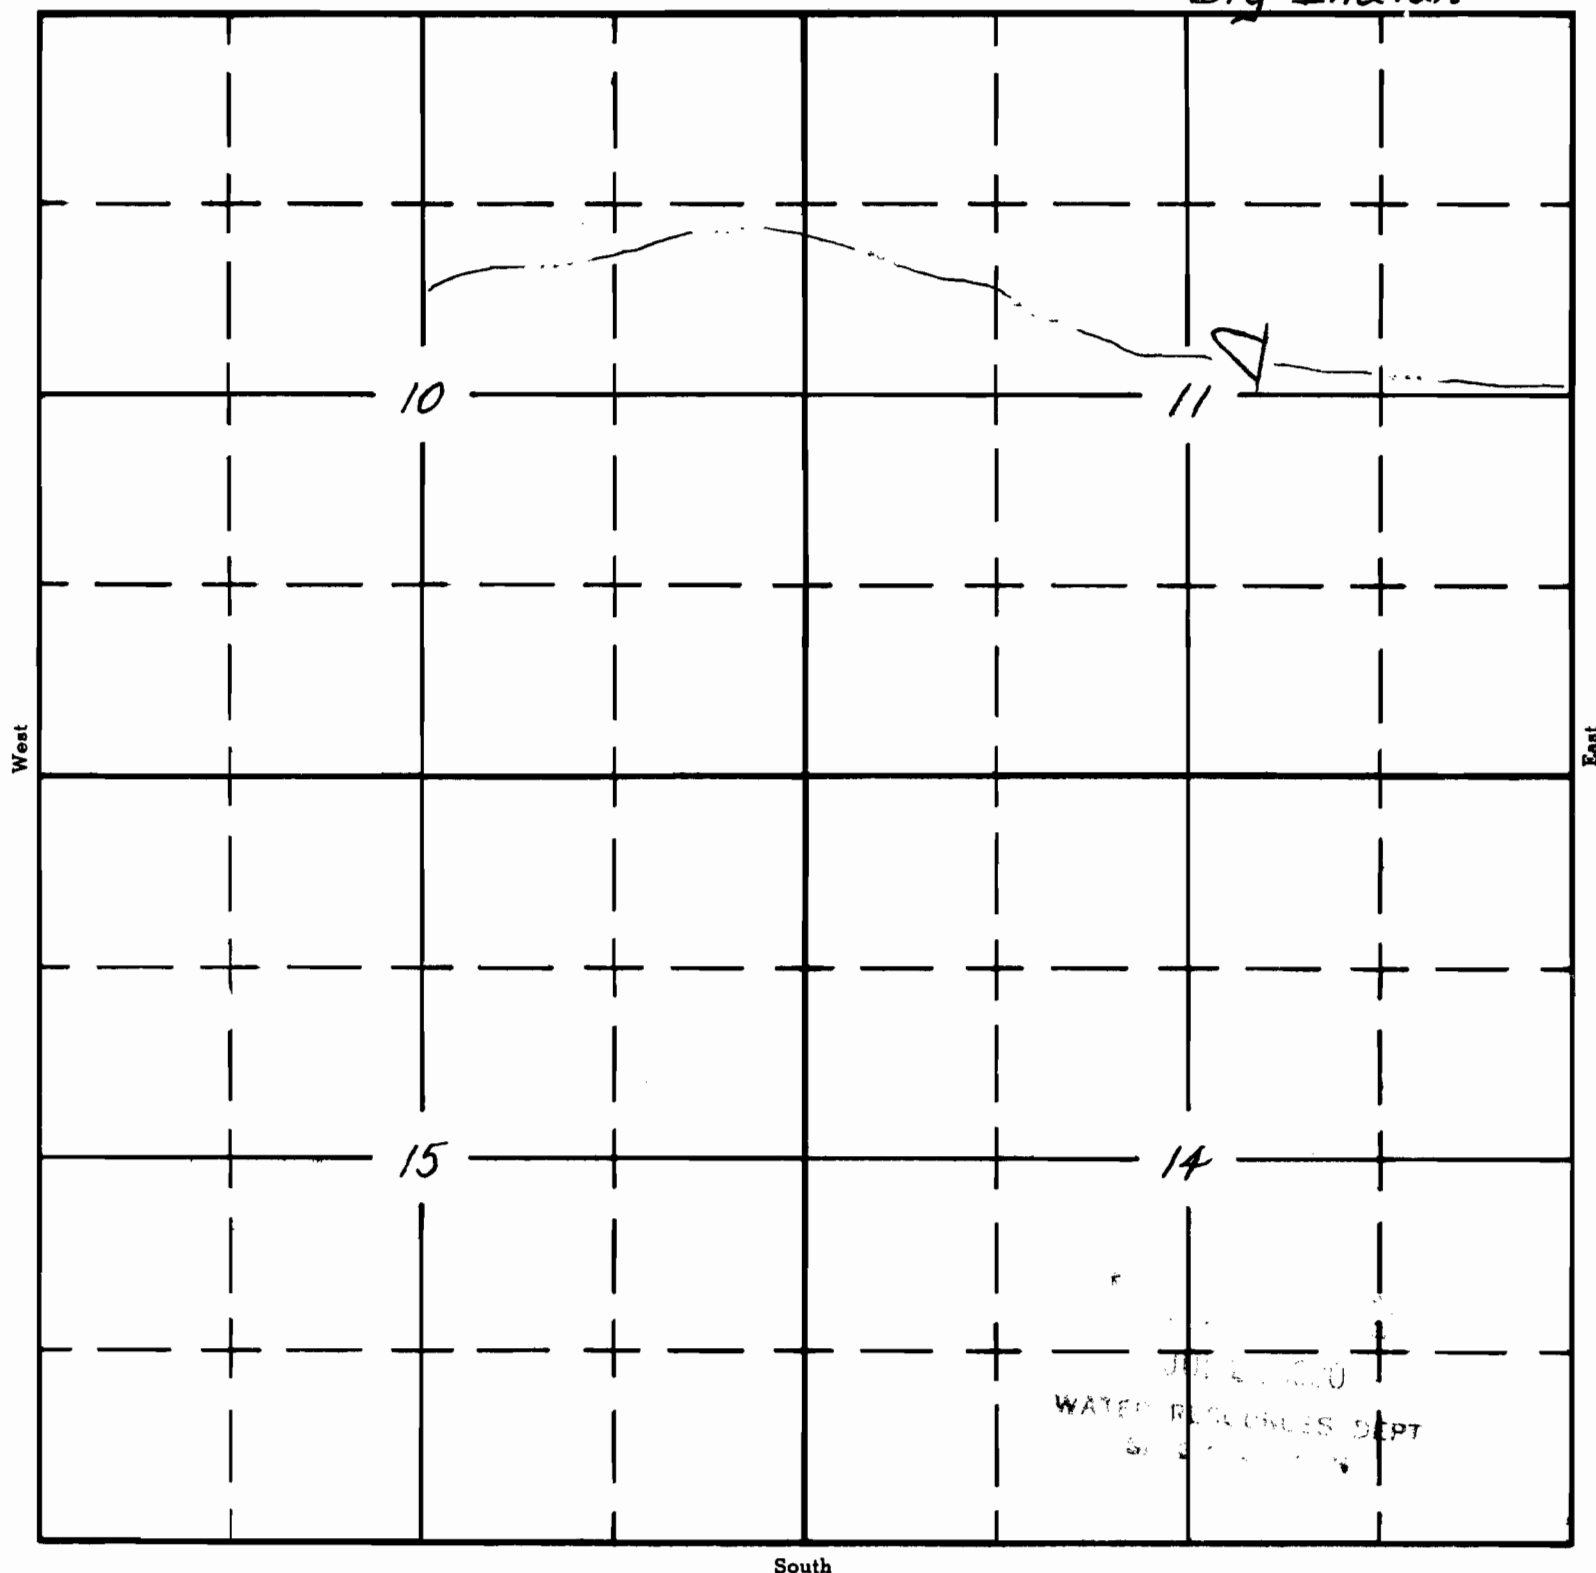

South

APPLICATION No.

PERMIT No.