


T.26 S., R.12 W., W.M.

LEGEND

- EXISTING DWELLING (PER PERMIT 28364)
- ⊞ IRRIGATED LAWN AND GARDEN (0.46 AC.)
- EXISTING DWELLING
- ▶ 0.46 AC. RES.

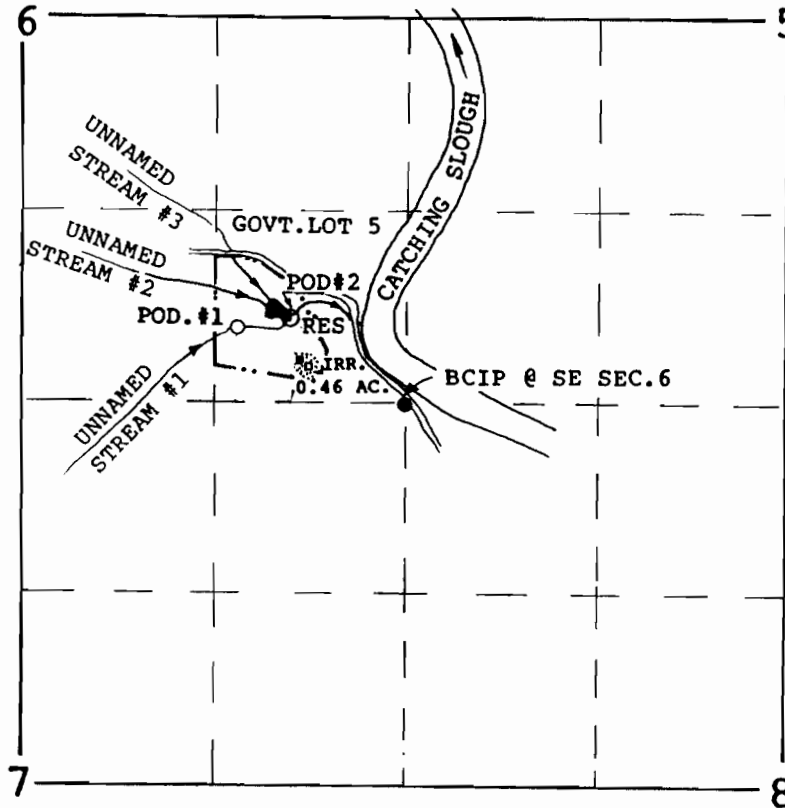

RESERVOIR LOCATED 583.5'N. AND 884.4'W. FROM SE COR. SEC. 6
 POD #1 LOCATED 515.1'N. AND 1072.3'W. FROM SE COR. SEC. 6
 POD #2 LOCATED 583.5'N. AND 884.4'W. FROM SE COR. SEC. 6

FINAL PROOF SURVEY

UNDER

APPLICATION NO. 71724 PERMIT NO. 51362
 R-71723 R-11416
 IN THE NAME OF

BEVERLY J. NELSON

SURVEYED SEPT. 24, 1992 BY CWRE KEITH JEHNKE



EXAMINERS DISCLAIMER STATEMENT

THE PREPARATION OF THIS MAP WAS FOR THE PURPOSE OF IDENTIFYING THE LOCATION OF THE WATER RIGHT ONLY AND HAS NO INTENT TO PROVIDE DIMENSIONS OR LOCATION OF PROPERTY OWNERSHIP LINES.