


T. 1 N., R. 3 W., W.M.

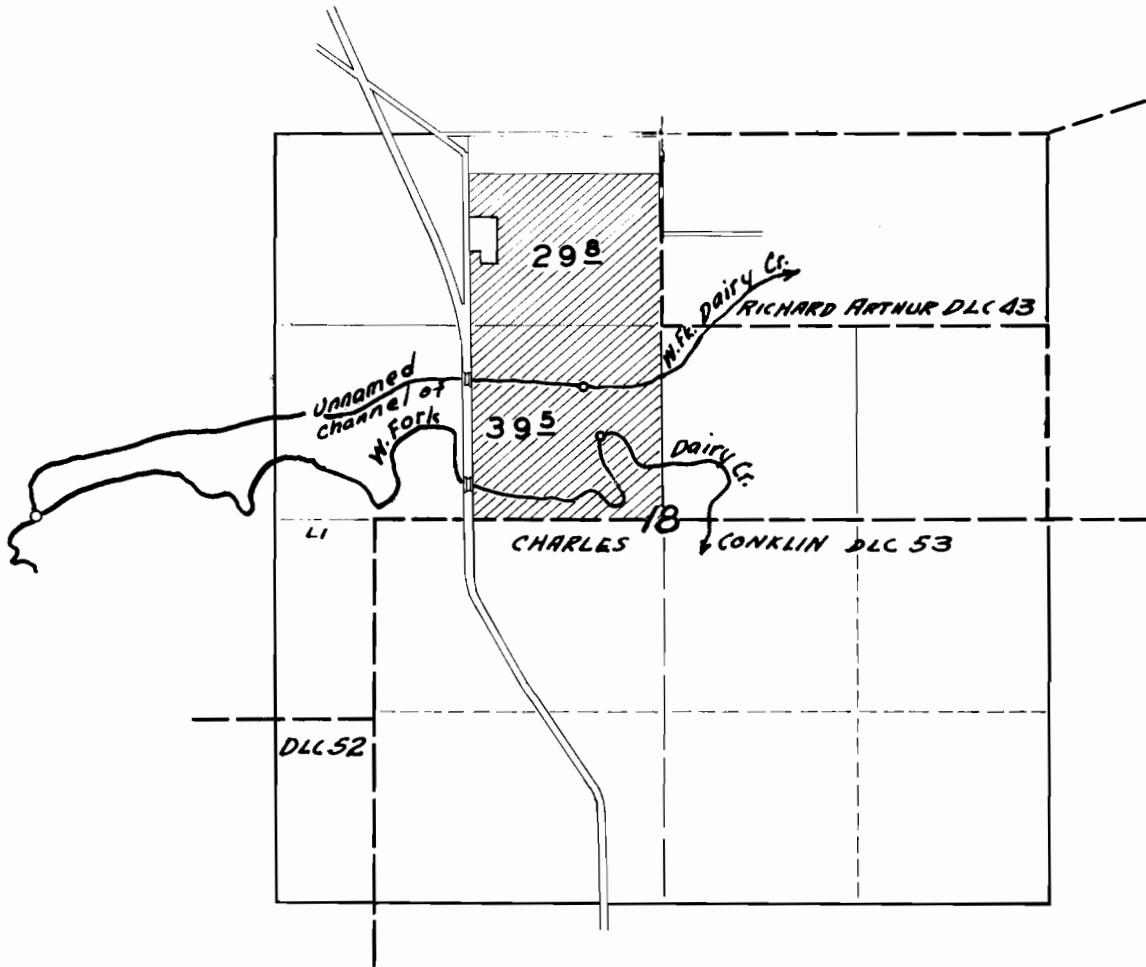

FINAL PROOF SURVEY

UNDER

Application No. 25064 Permit No. 19737

IN NAME OF

W. E. VANDEHEY

Surveyed 4 - 17, 1956 by R. H. WHITBY