


T.5S.R.1W.W.M.

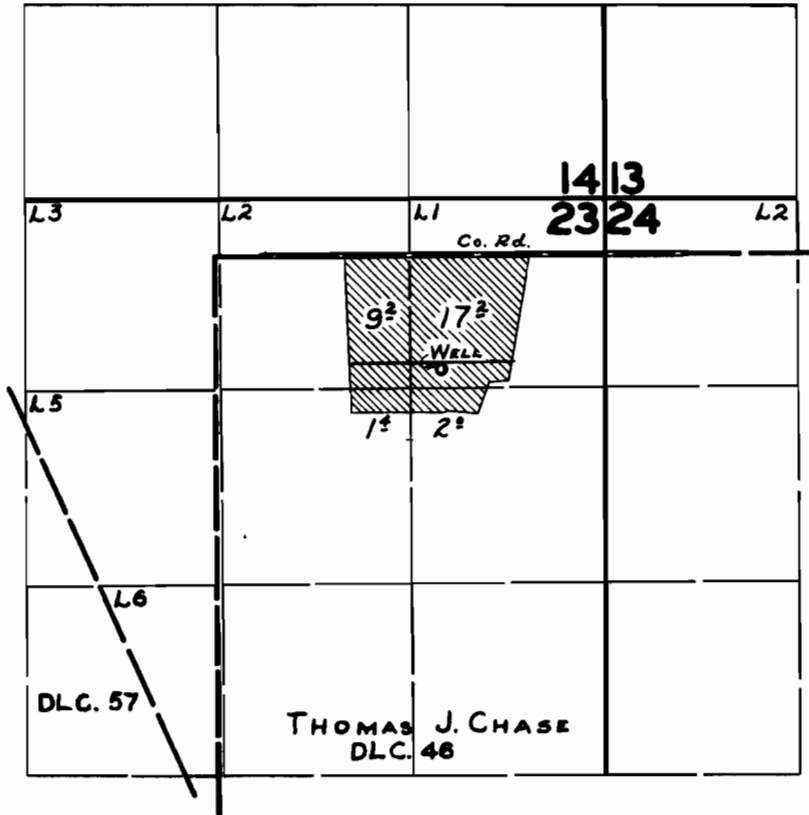

FINAL PROOF SURVEY
UNDER

Application No. G-398 Permit No. G-366
IN NAME OF

ALTON H. DOUTHIT

Surveyed SEPT. 4 1959, by R. H. JACKSON