


T. 3 N., R. 3 W., W.M.

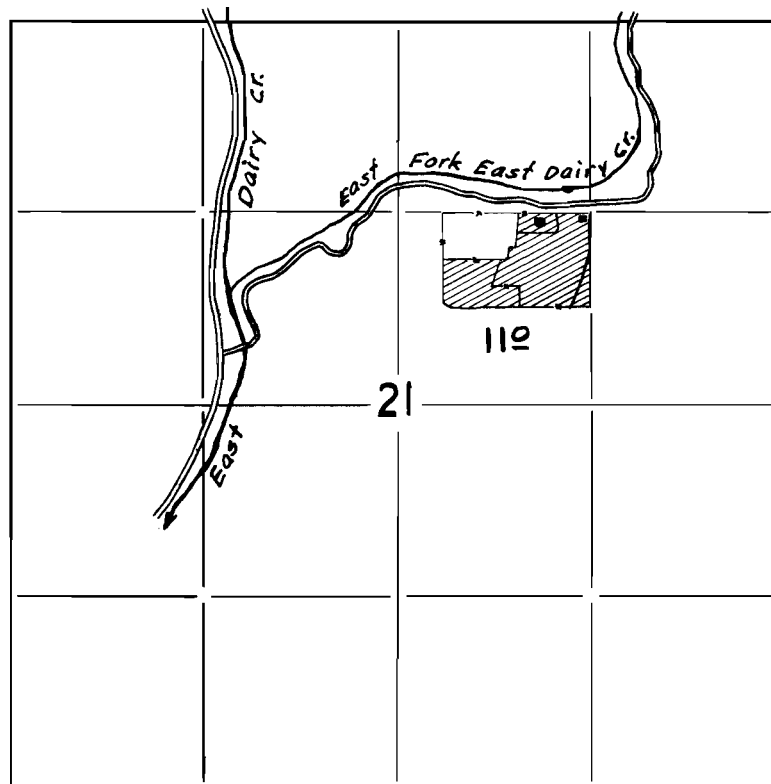

FINAL PROOF SURVEY

UNDER

Application No. 26396 Permit No. 20707

IN NAME OF

Clarence W. Maas

Re-Surveyed July 2, 1957, by G. W. Adelman