

Form AI-187
March 1961


UNITED STATES
DEPARTMENT OF THE INTERIOR
BUREAU OF LAND MANAGEMENT

SECTION

S 27

Oregon State Water Filings

TOWNSHIP 30S, RANGE 46E, W. M.

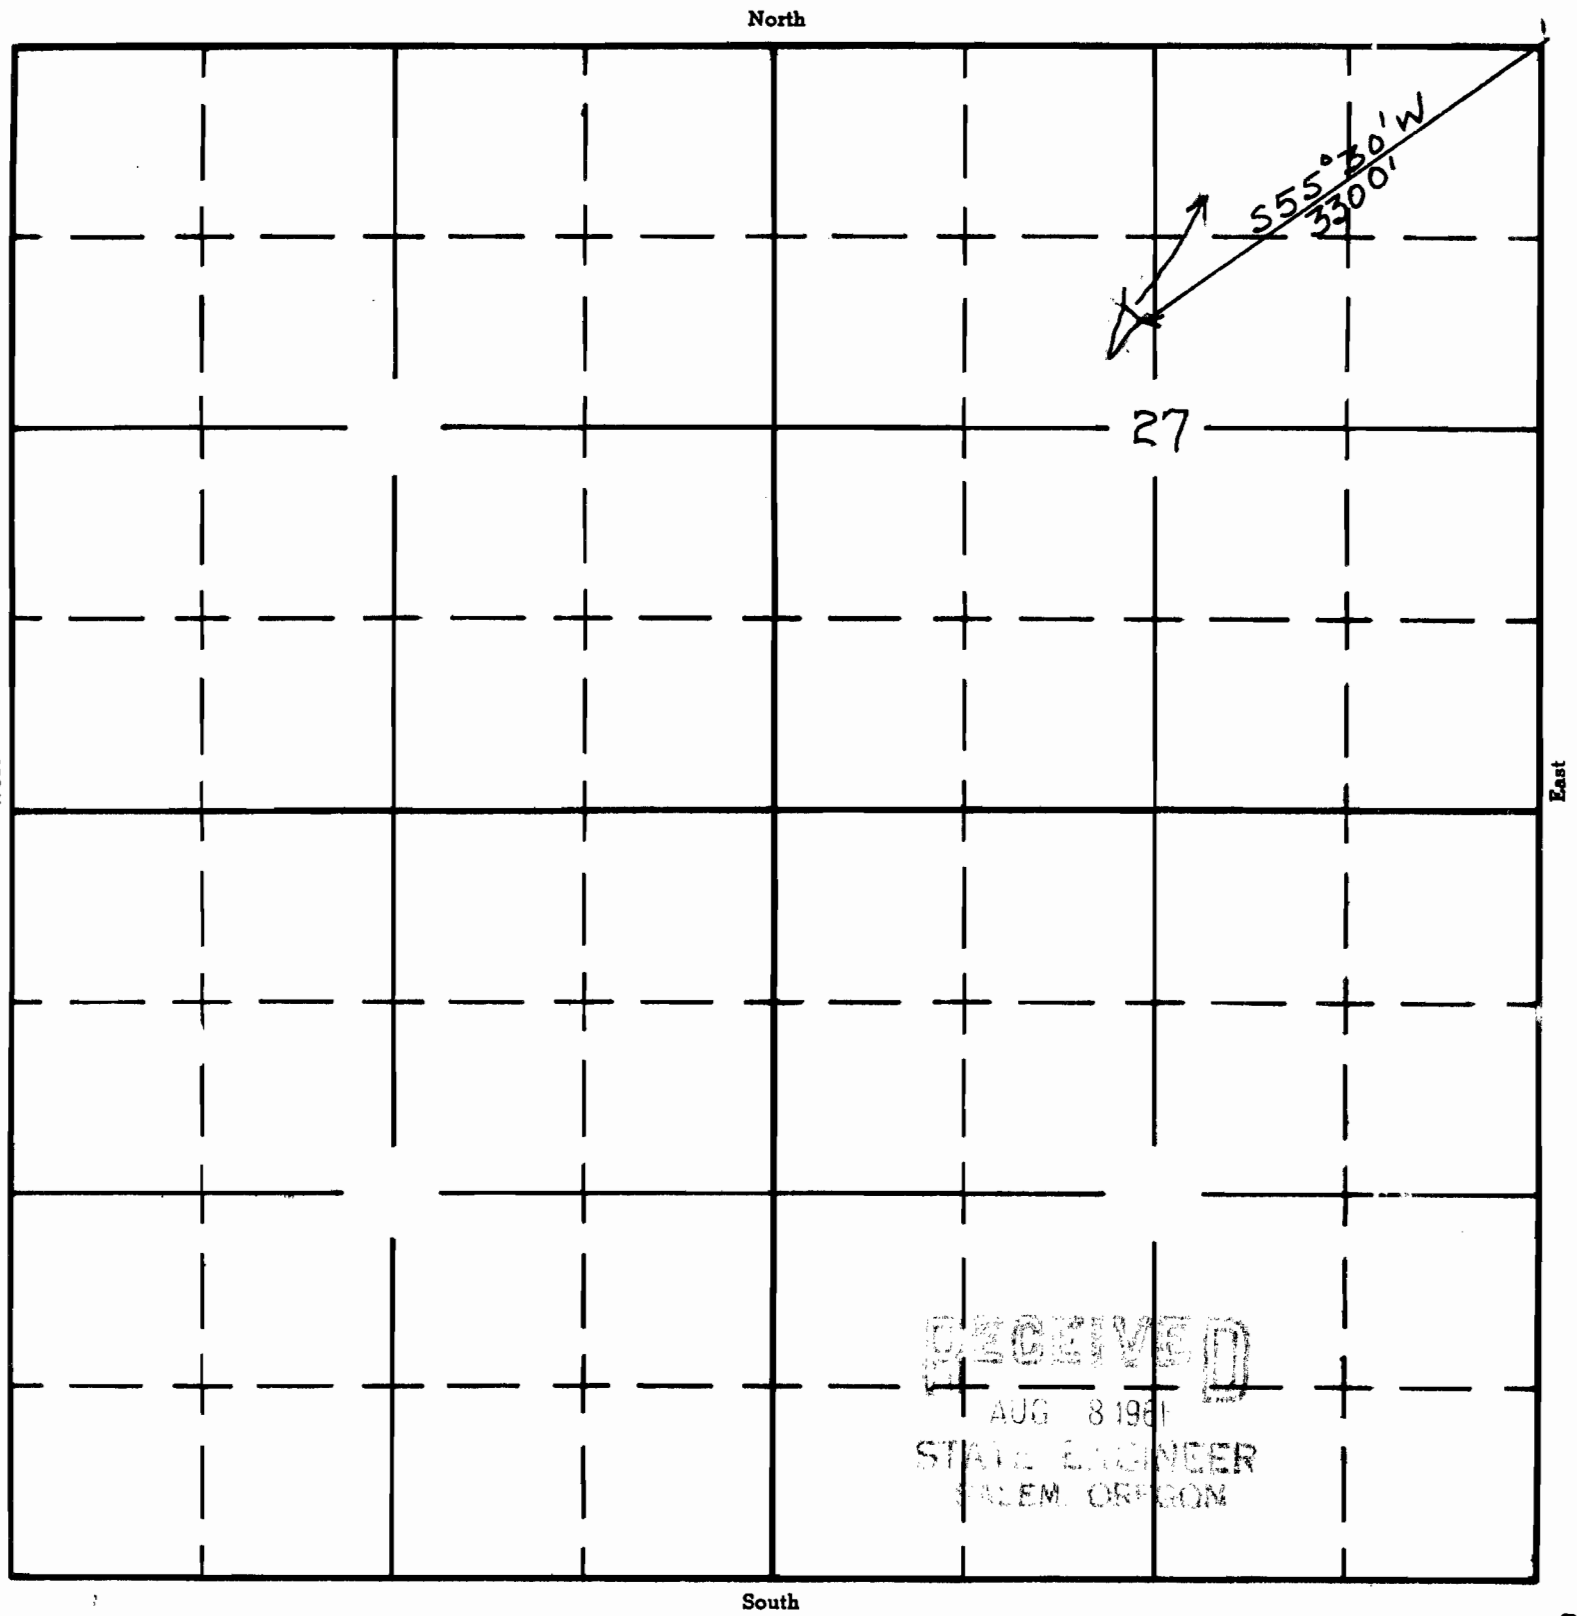

RECEIVED
AUG 8 1961
STATE ENGINEER
SALEM, OREGON

APPLICATION No. R-36618
PERMIT No. R 7260