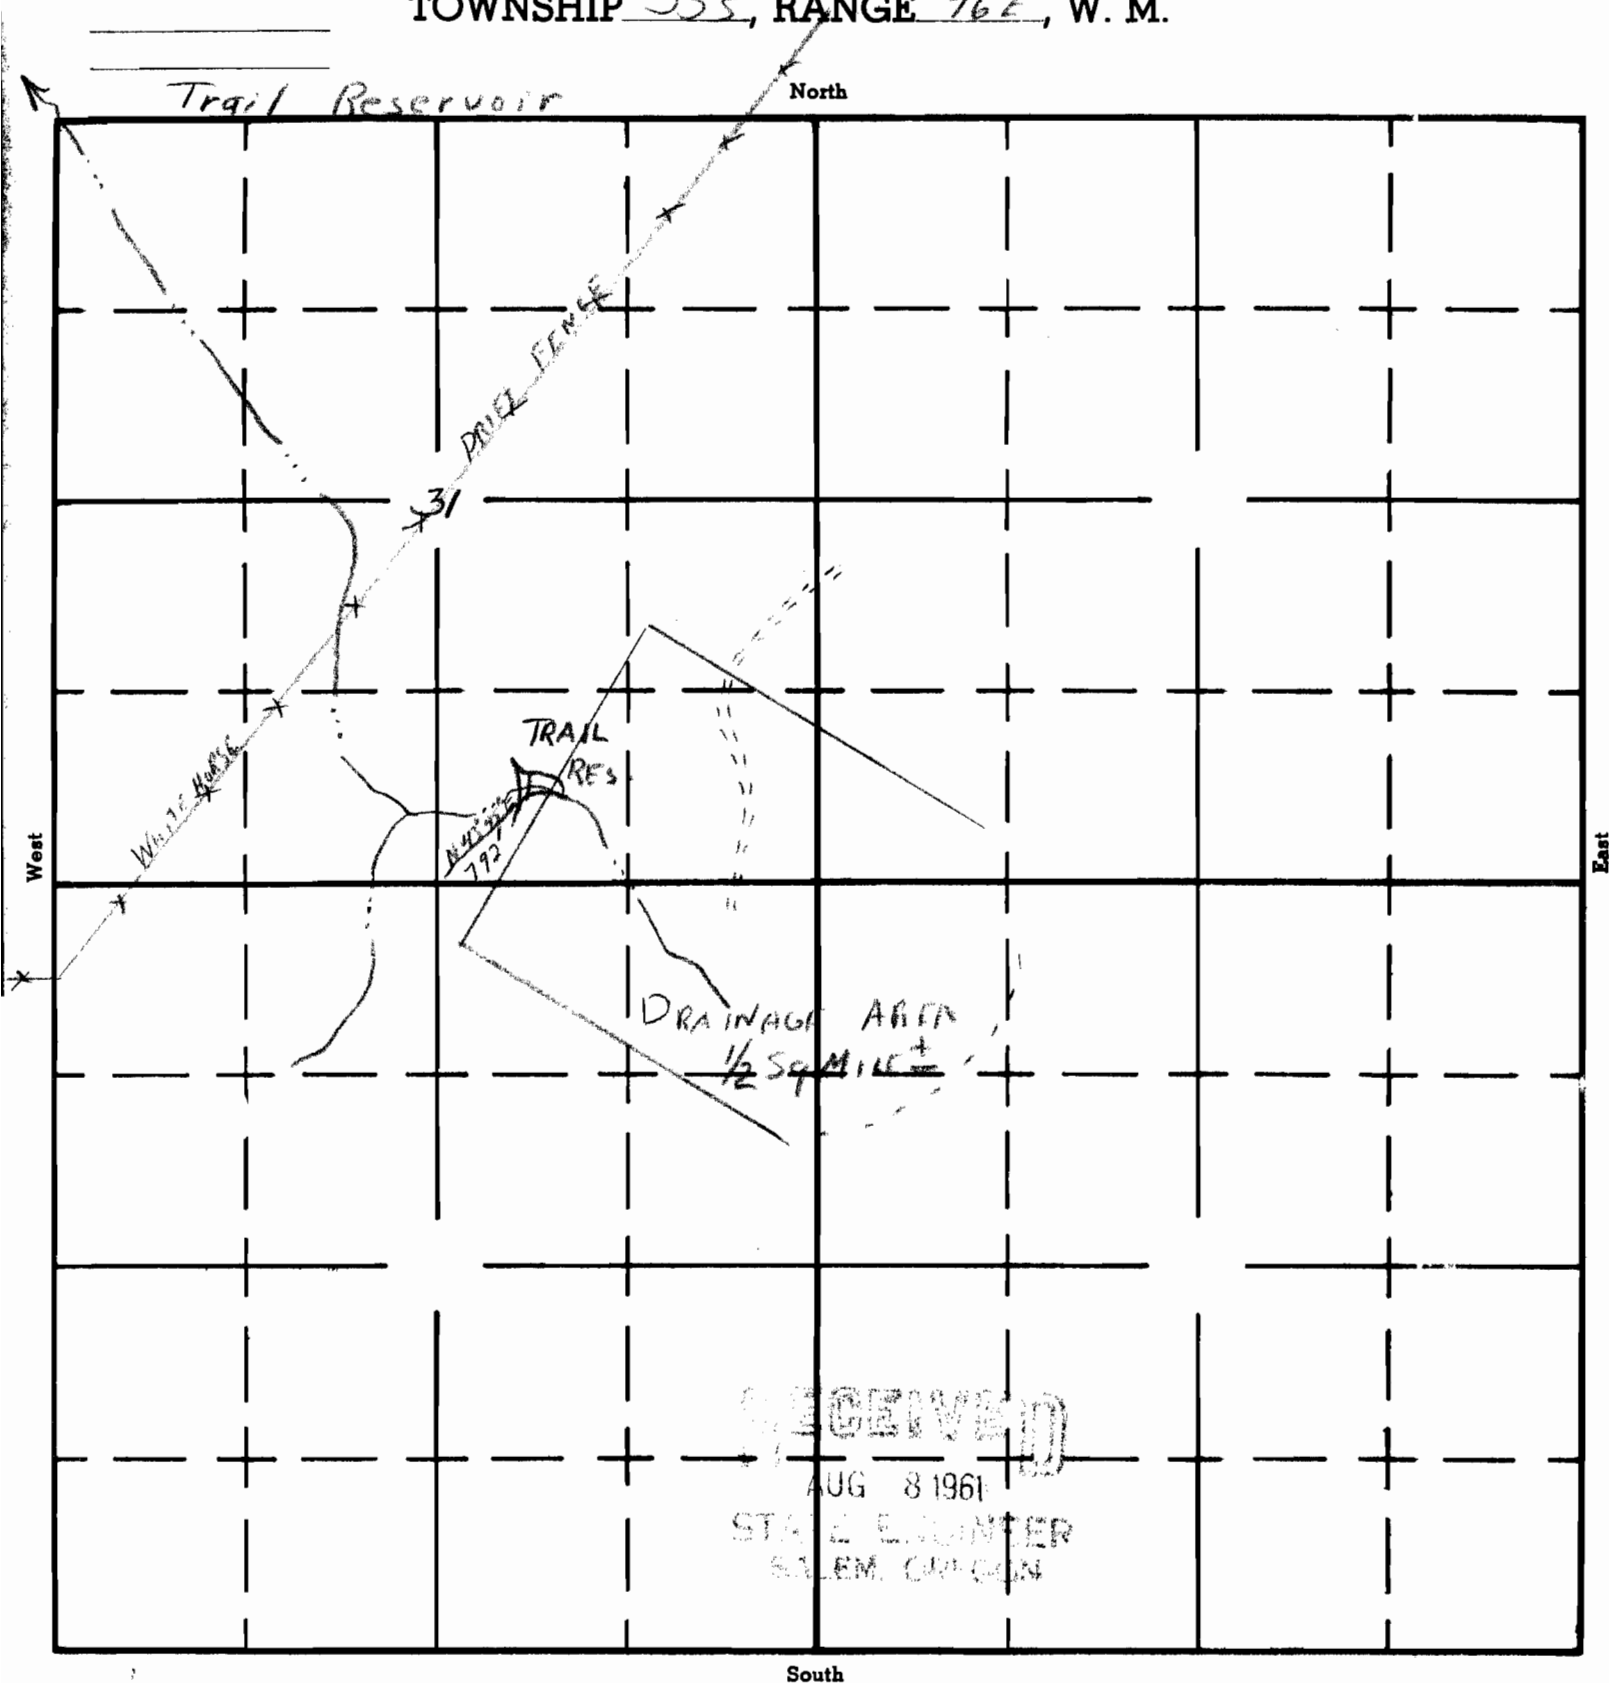


Oregon State Water Filings

TOWNSHIP 33S, RANGE 46E, W. M.

APPLICATION No. *R-36620*
PERMIT No. *R-3787*