


Form AI-187
March 1961

UNITED STATES
DEPARTMENT OF THE INTERIOR
BUREAU OF LAND MANAGEMENT

SECTION _____

Oregon State Water Filings

TOWNSHIP 31S, RANGE 44E, W. M.

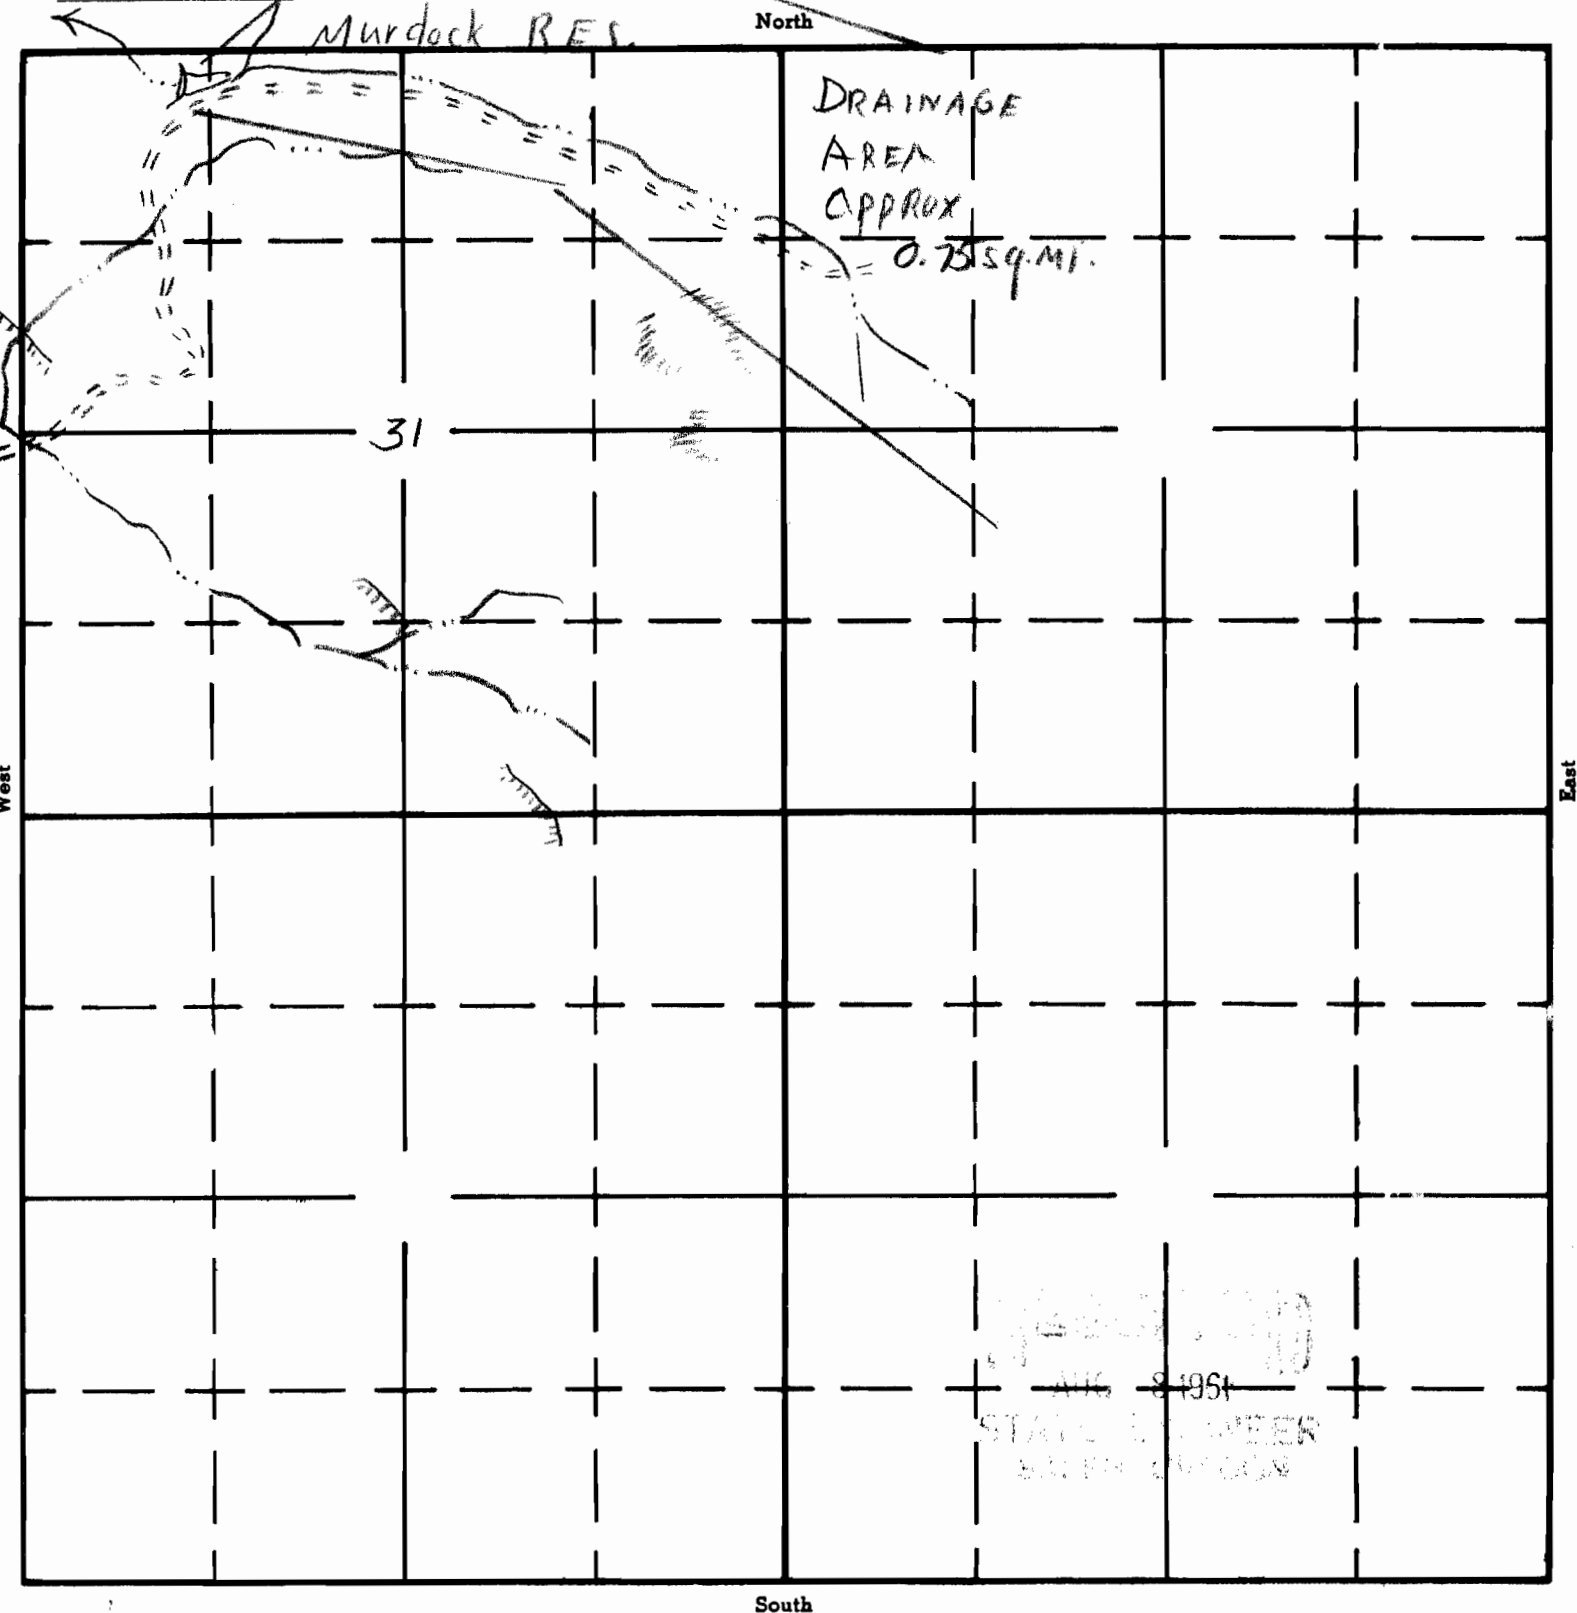

APPLICATION No. R-36622
PERMIT No. R-4257