

UNITED STATES
DEPARTMENT OF THE INTERIOR
BUREAU OF LAND MANAGEMENT


SECTION _____

Oregon State Water Filings

TOWNSHIP 34S, RANGE 46E, W. M.

Long Canyon Res. No. 2

North

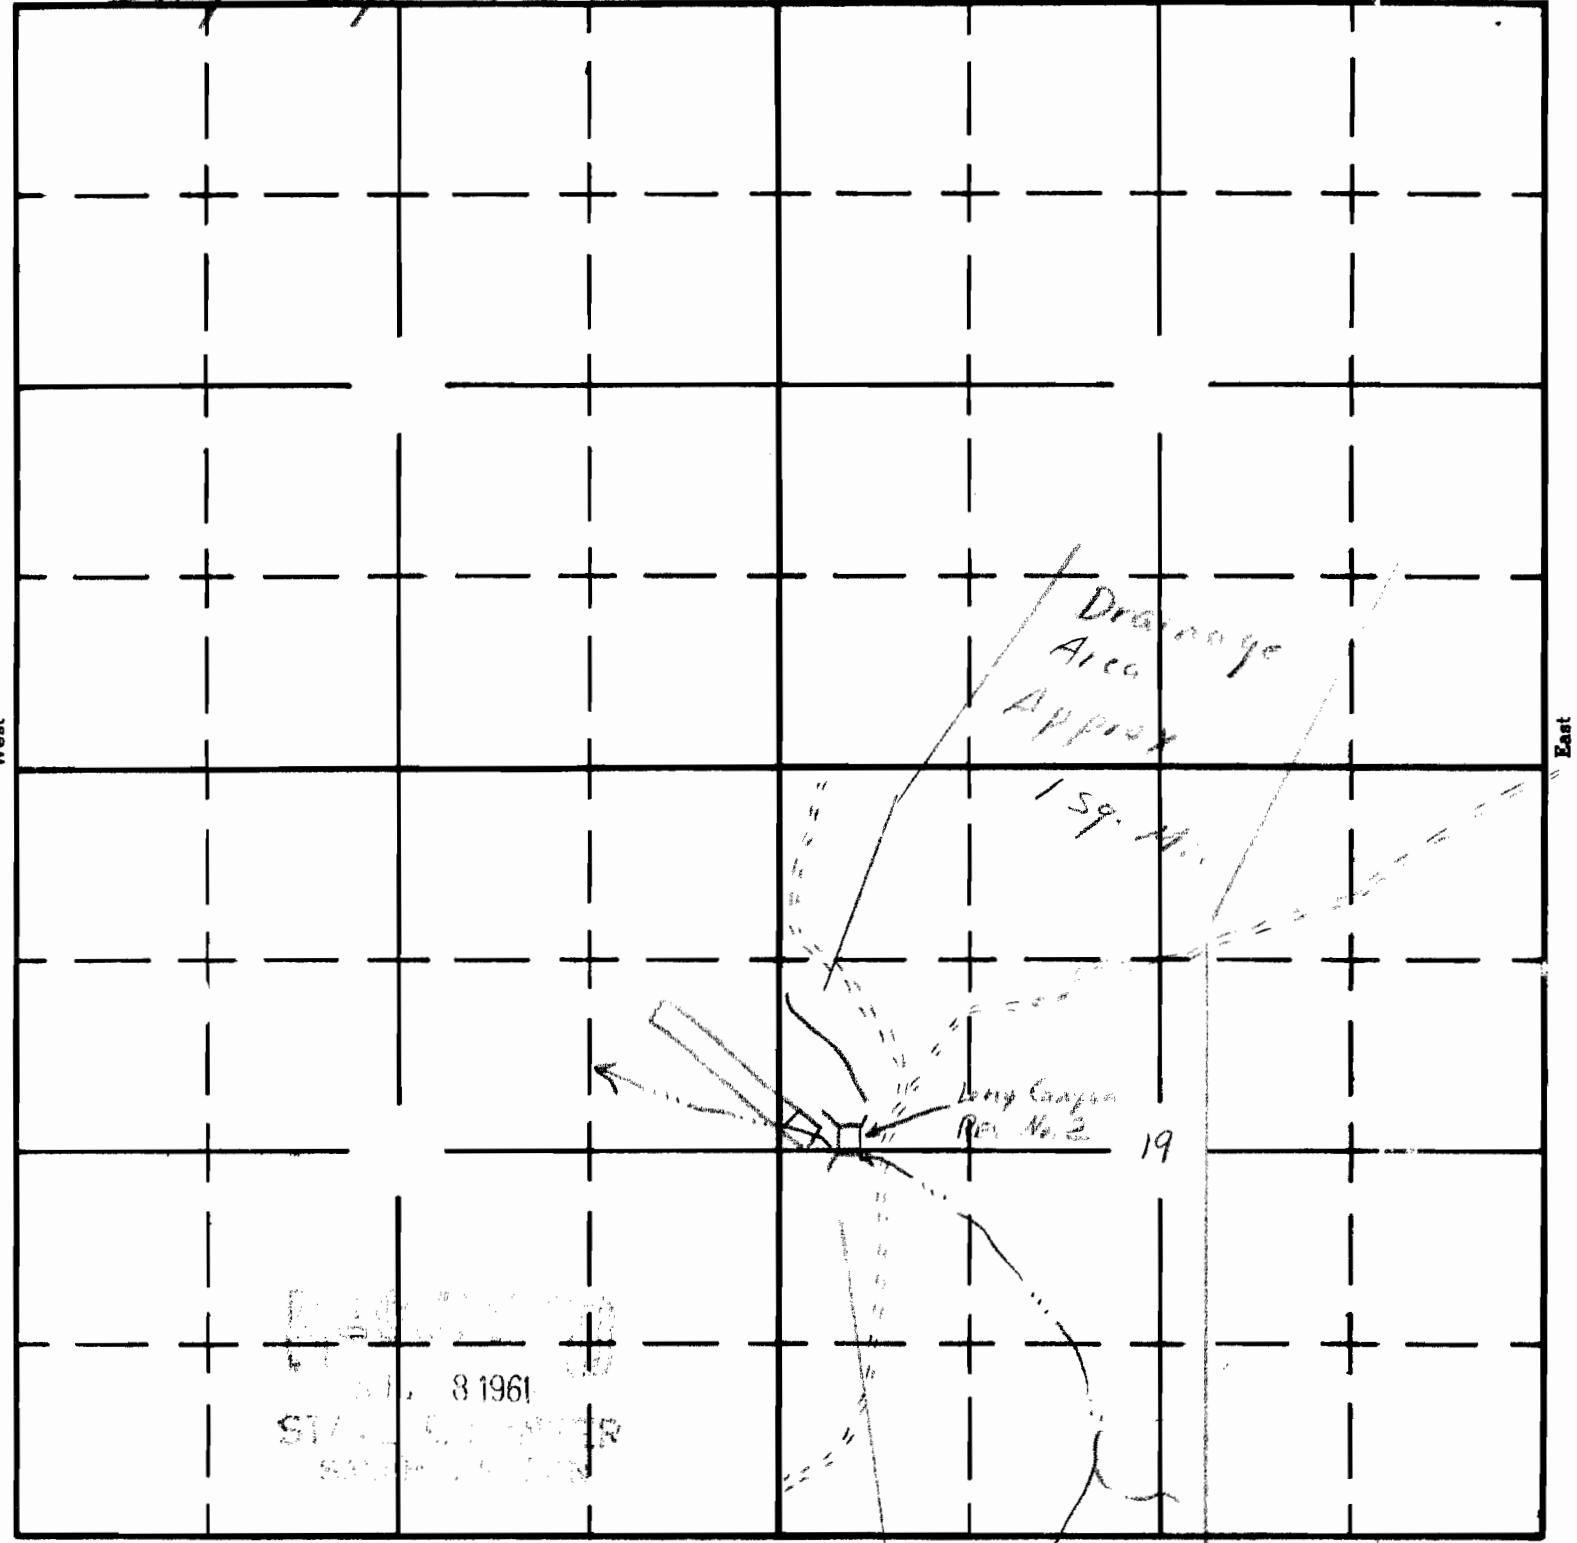

SOUTH

South

APPLICATION No. R-36627
PERMIT No. R-4262