

Form A1-187
March 1961

UNITED STATES
DEPARTMENT OF THE INTERIOR
BUREAU OF LAND MANAGEMENT


SECTION _____

Oregon State Water Filings

TOWNSHIP 31S, RANGE 43E, W. M.

FRETWELL RESERVOIR

North

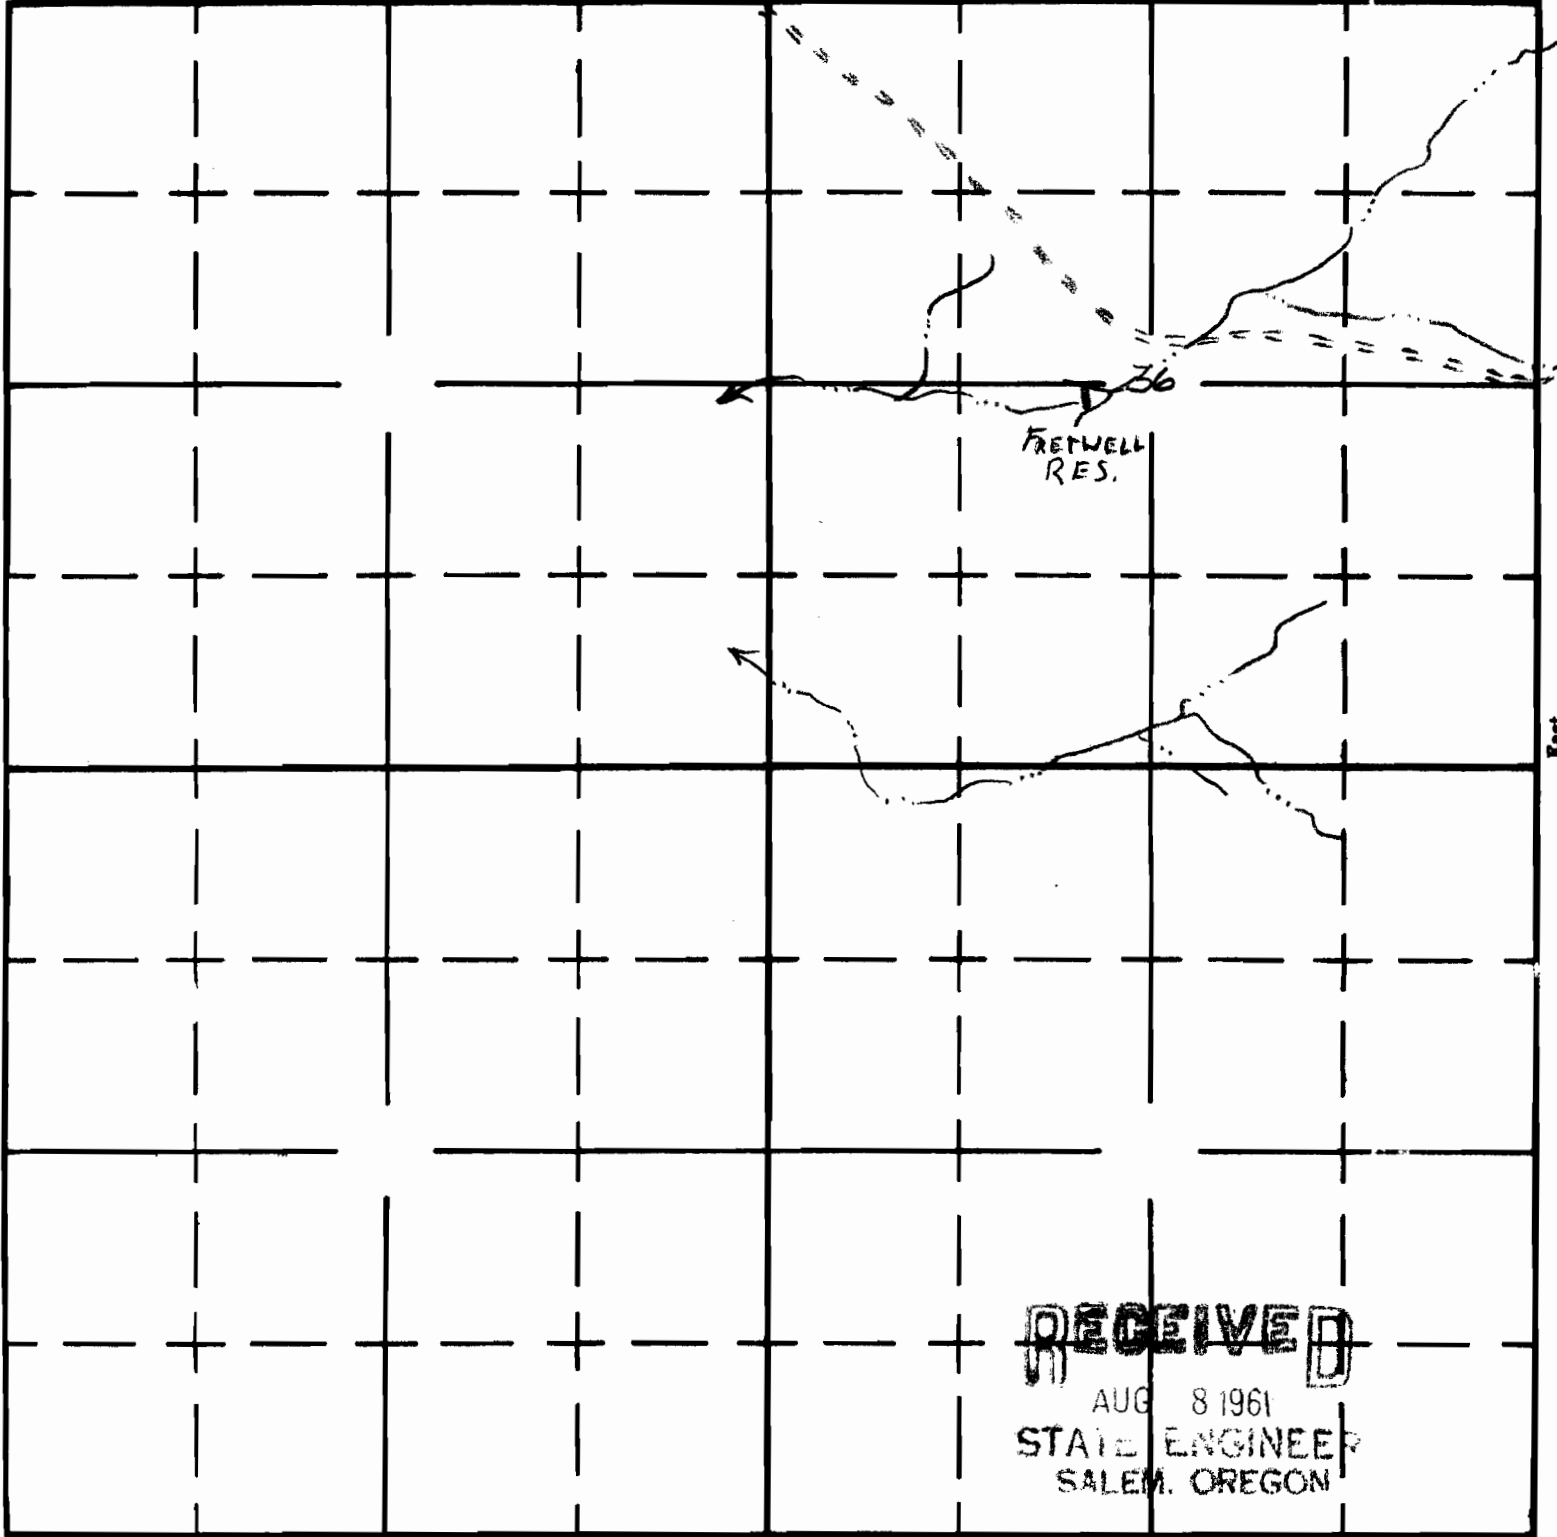

RECEIVED

AUG 8 1961
STATE ENGINEER
SALEM, OREGON

South

APPLICATION No. *R-36646*

PERMIT No. *R-3797*