

UNITED STATES
DEPARTMENT OF THE INTERIOR
BUREAU OF LAND MANAGEMENT

SECTION


35

Oregon State Water Filings

TOWNSHIP 275, RANGE 14E, W. M.

Schnabel Cr. Res.

North

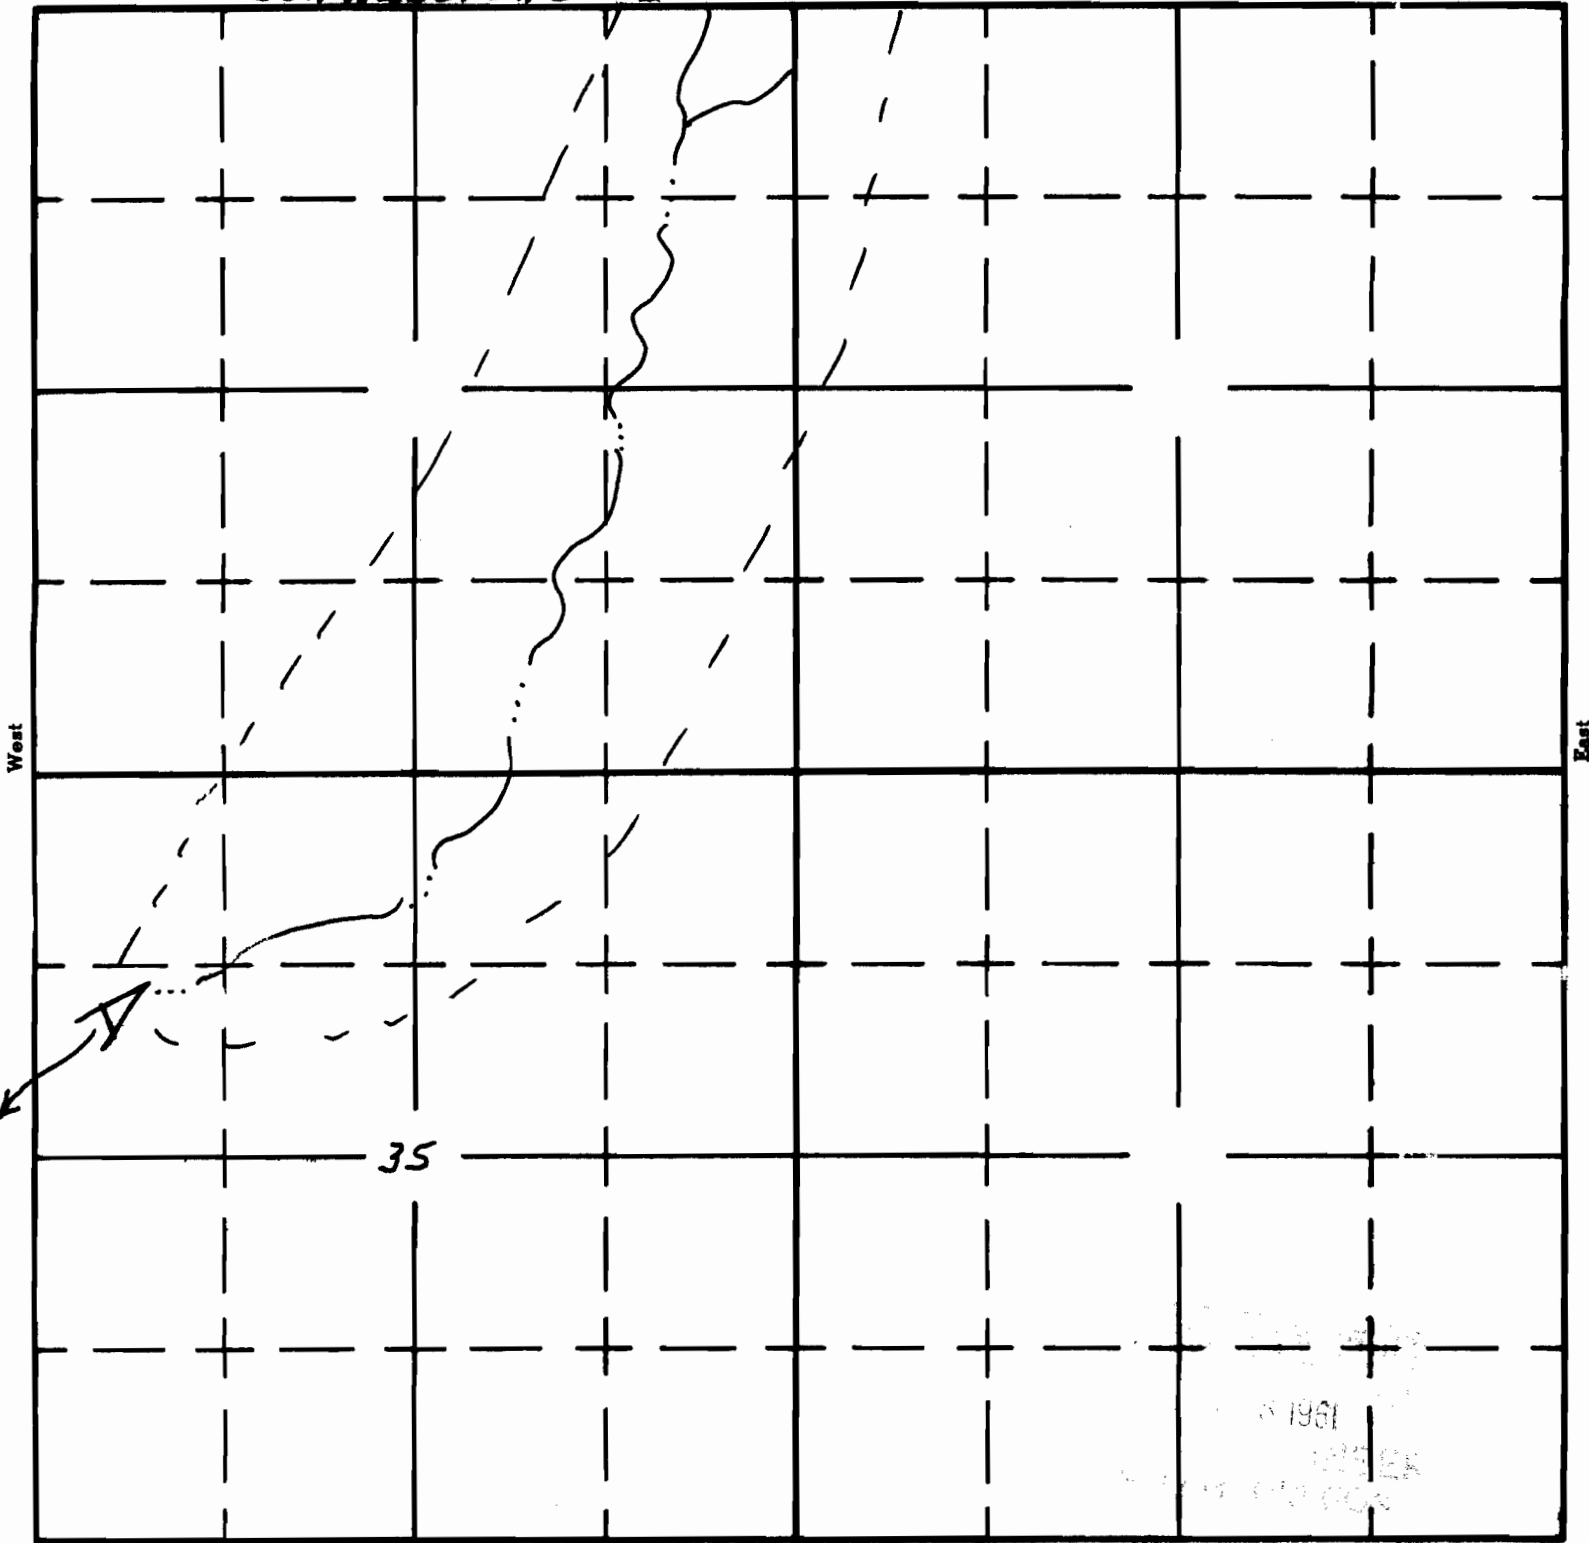

*Drainage Area
Approx. 1 sq. mi.*

South

APPLICATION No. R-36647
PERMIT No. R-3798