

Form Al-187
March 1961

UNITED STATES
DEPARTMENT OF THE INTERIOR
BUREAU OF LAND MANAGEMENT


SECTION

28

Oregon State Water Filings

TOWNSHIP 27S, RANGE 14E, W. M.

McCain Field Res. No. 2 North

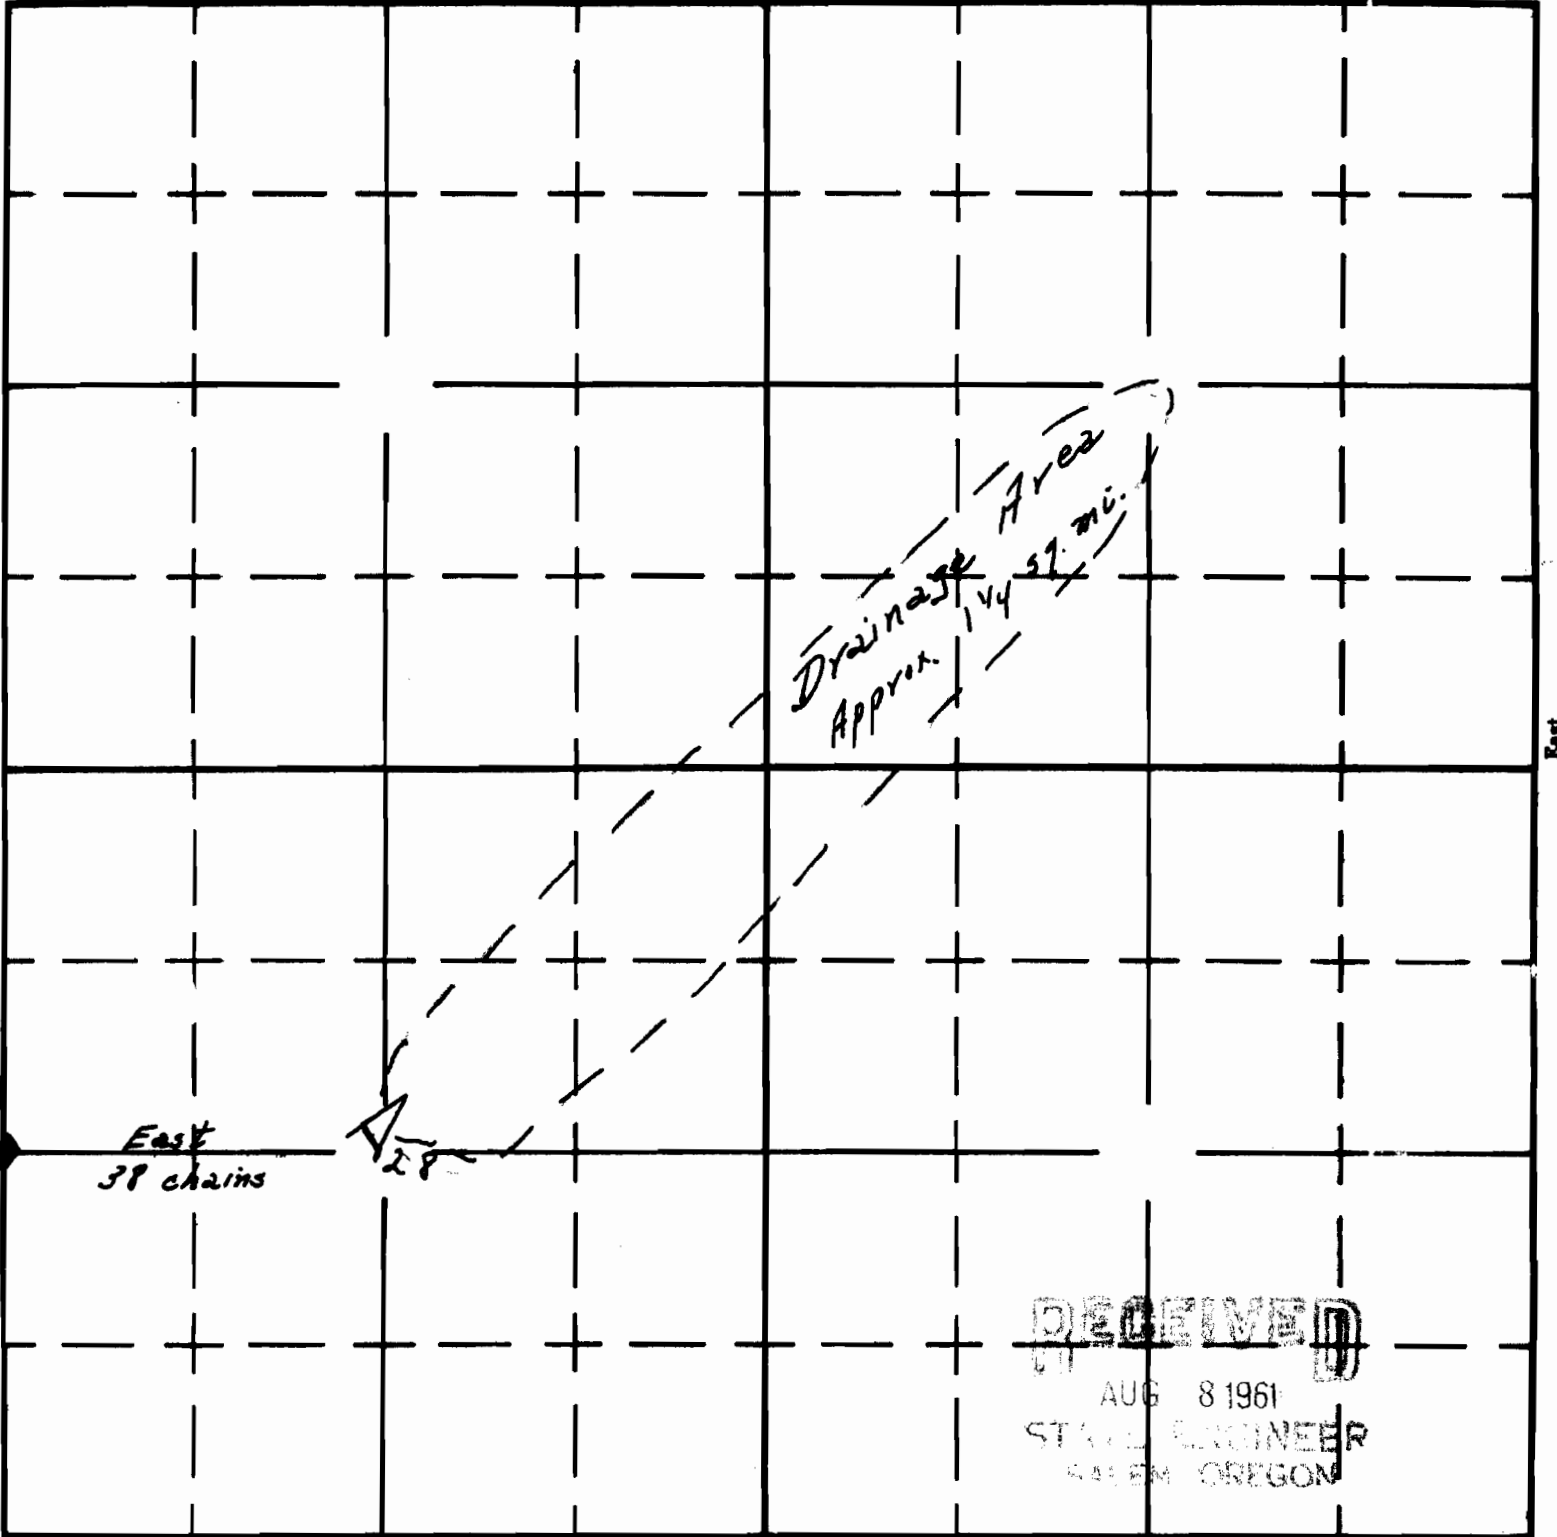

RECEIVED
AUG 8 1961
STATE ENGINEER
SALEM OREGON

APPLICATION No. R-36670

PERMIT No. R-2947