

Form AI-187
March 1961

UNITED STATES
DEPARTMENT OF THE INTERIOR
BUREAU OF LAND MANAGEMENT


SECTION

Oregon State Water Filings

S 33

TOWNSHIP 29 S, RANGE 42 E, W. M.

White Rock Creek Res. North

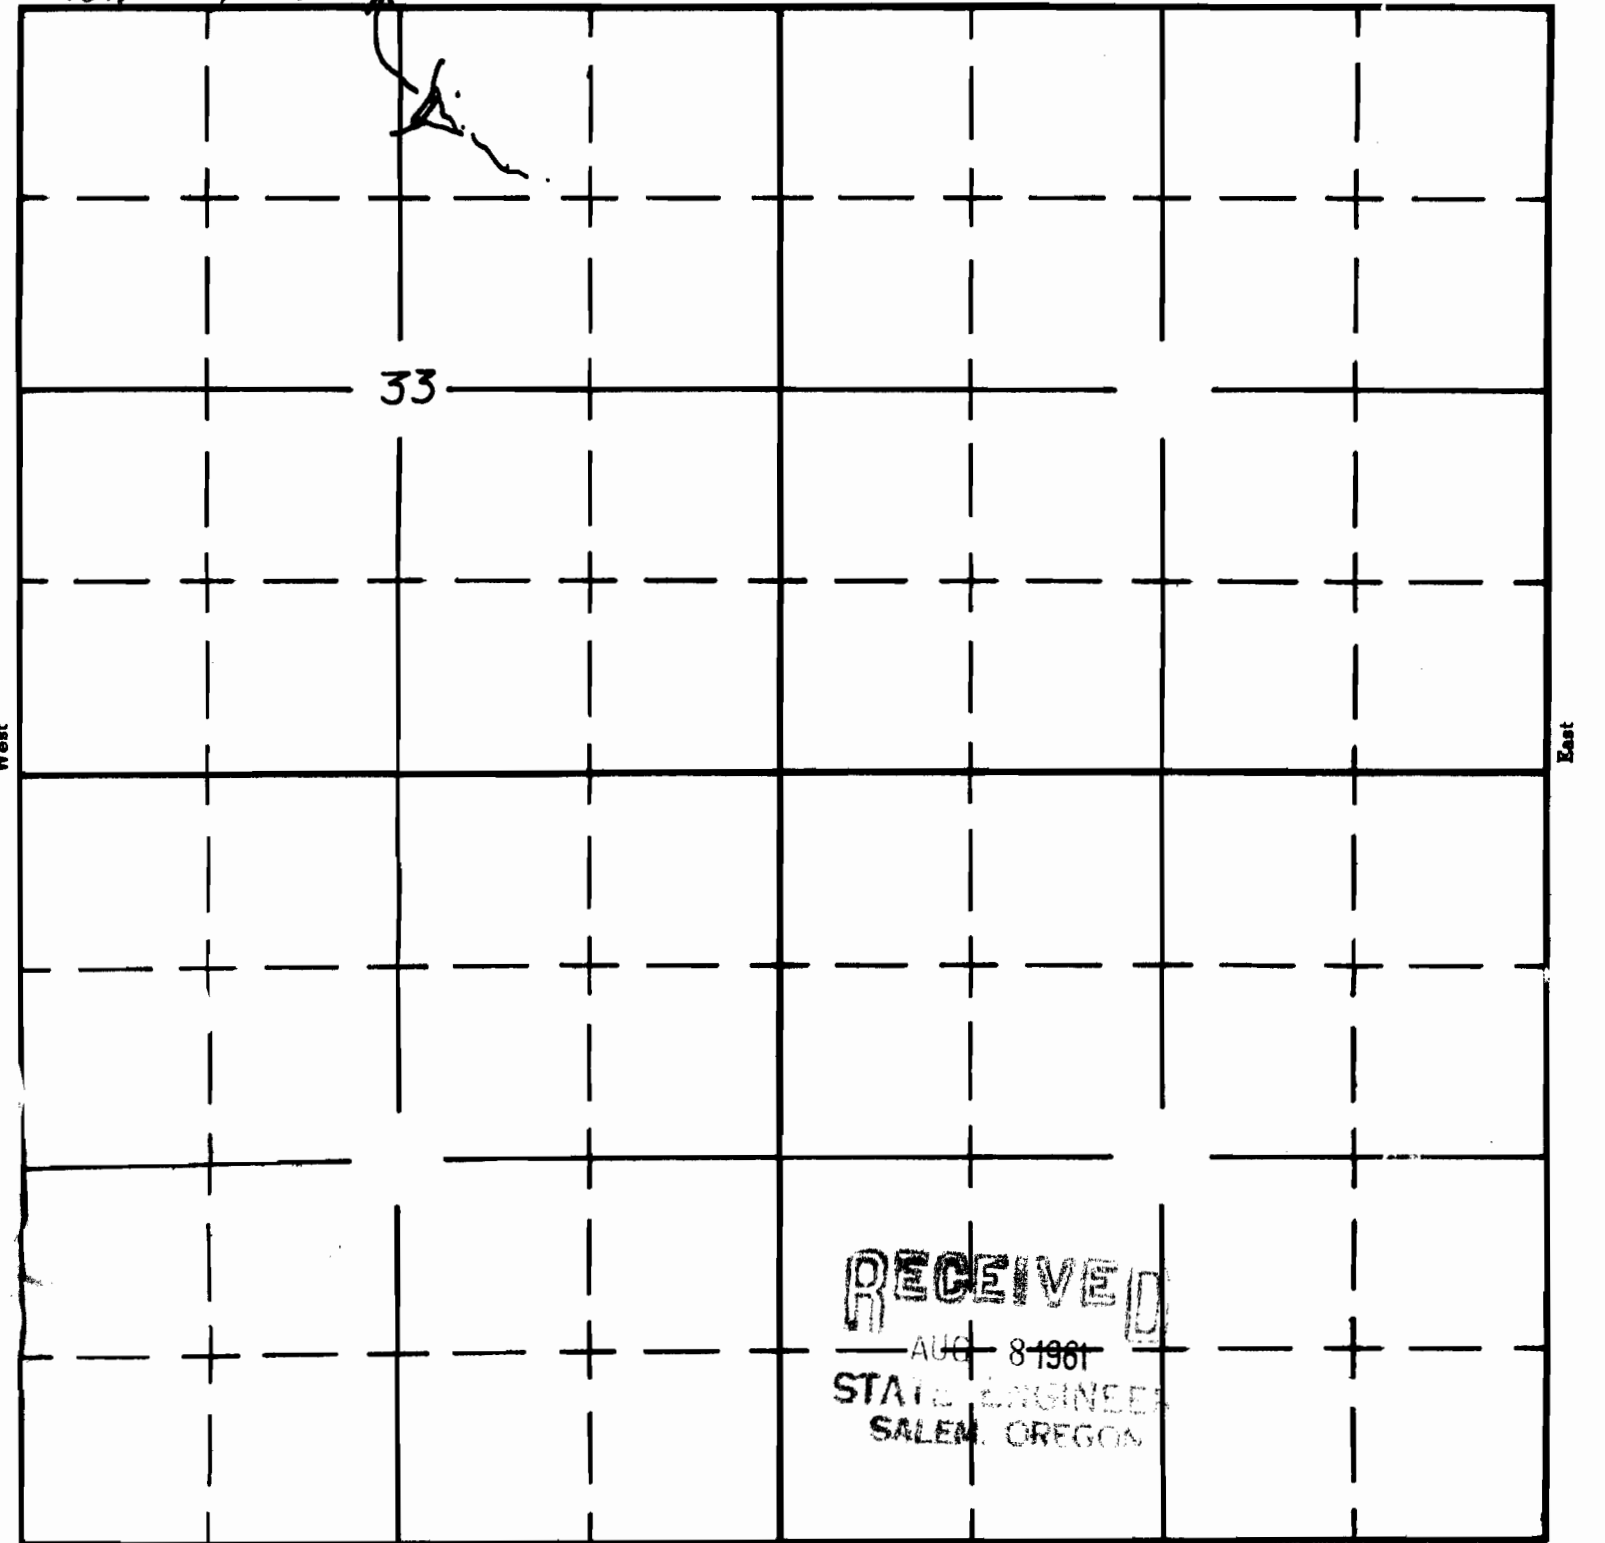

APPLICATION No. R-36730
PERMIT No. R-4293