

Form A1-187
March 1961

UNITED STATES
DEPARTMENT OF THE INTERIOR
BUREAU OF LAND MANAGEMENT


SECTION

Oregon State Water Filings

S 26

TOWNSHIP 28 S, RANGE 46 E, W. M.

North

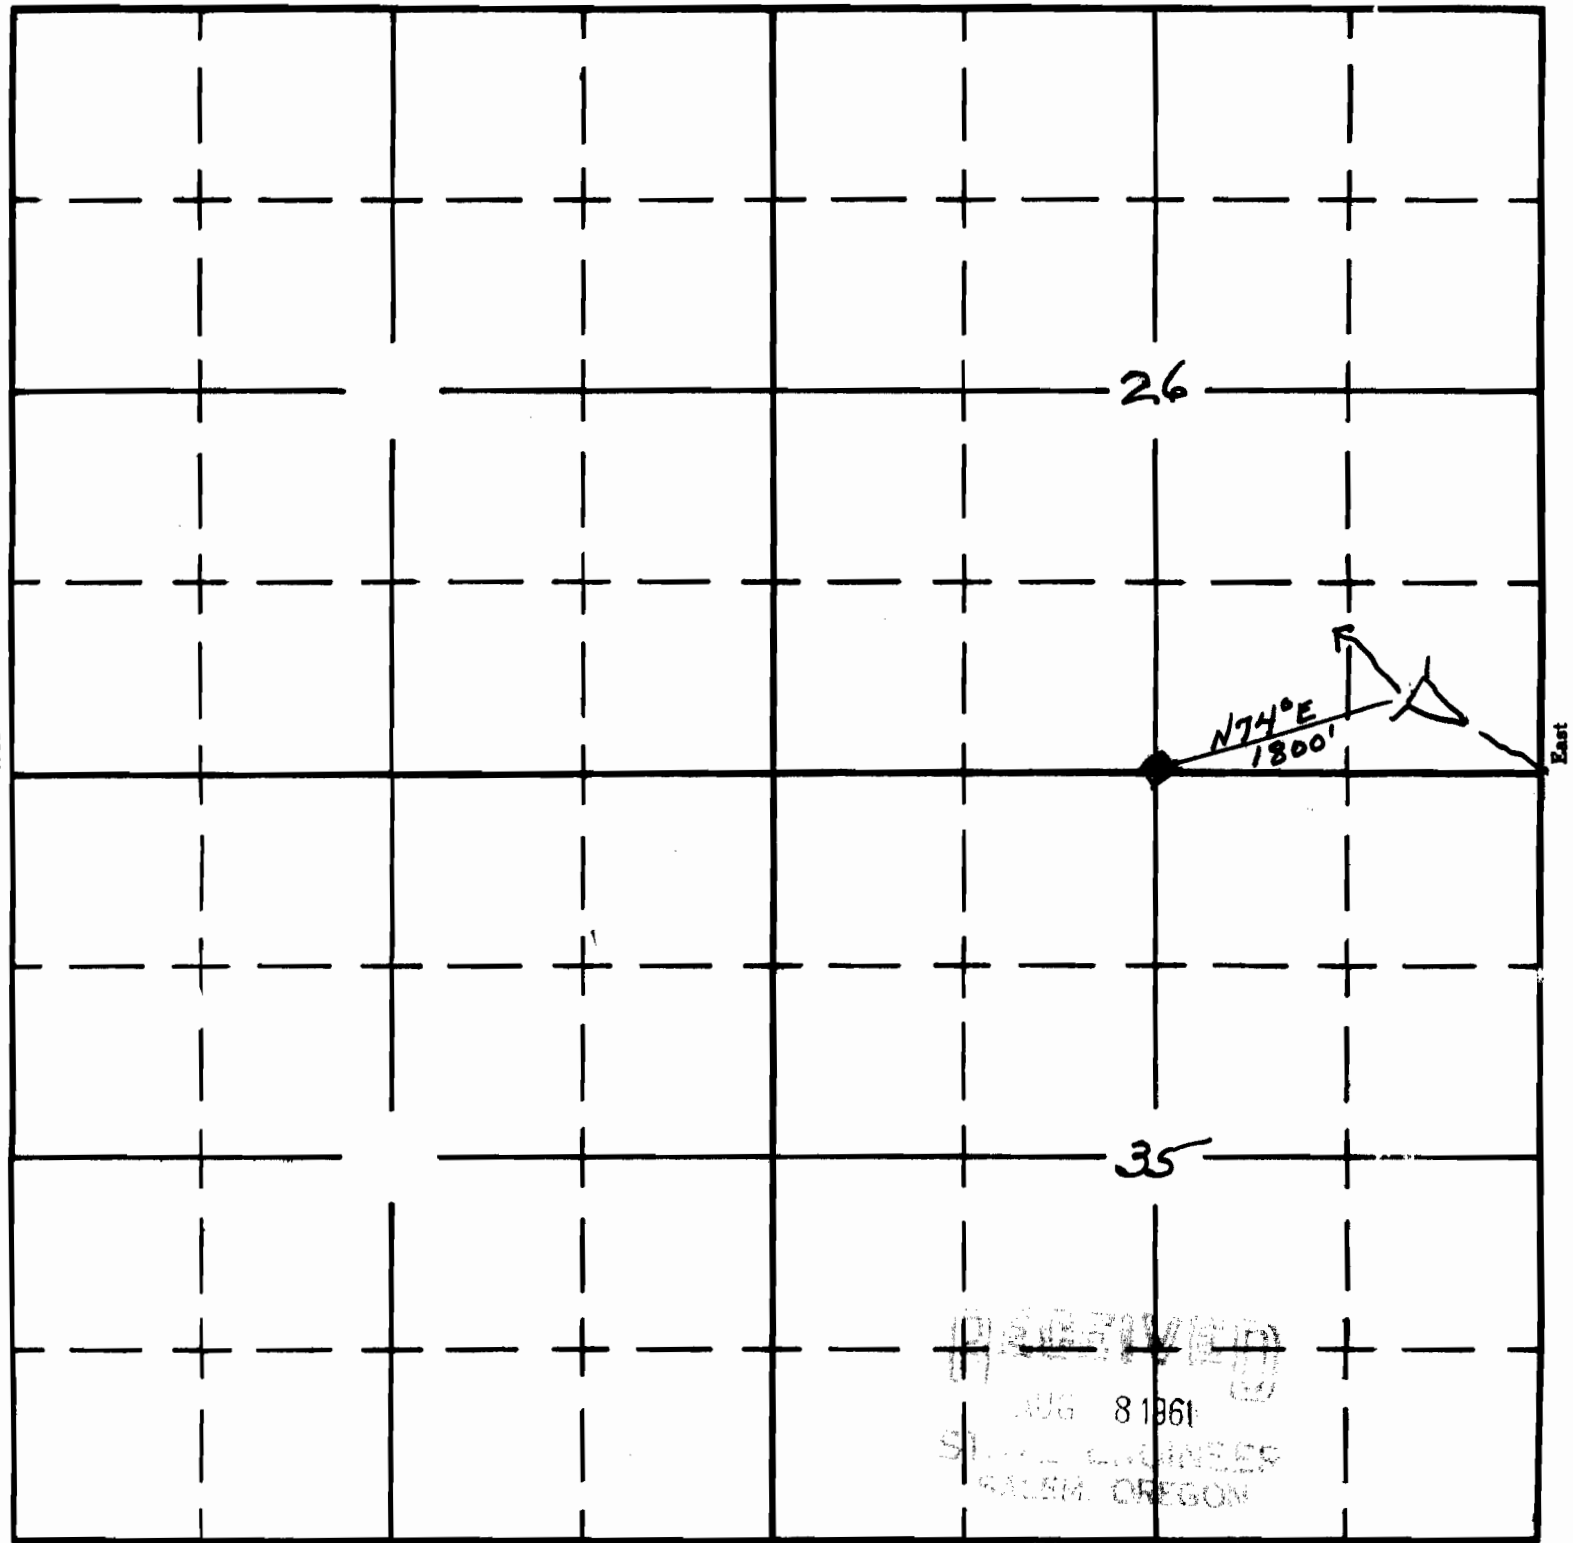

RECEIVED
AUG 8 1961
STATE ENGINEER

APPLICATION No. R-36748
PERMIT No. R-4310