


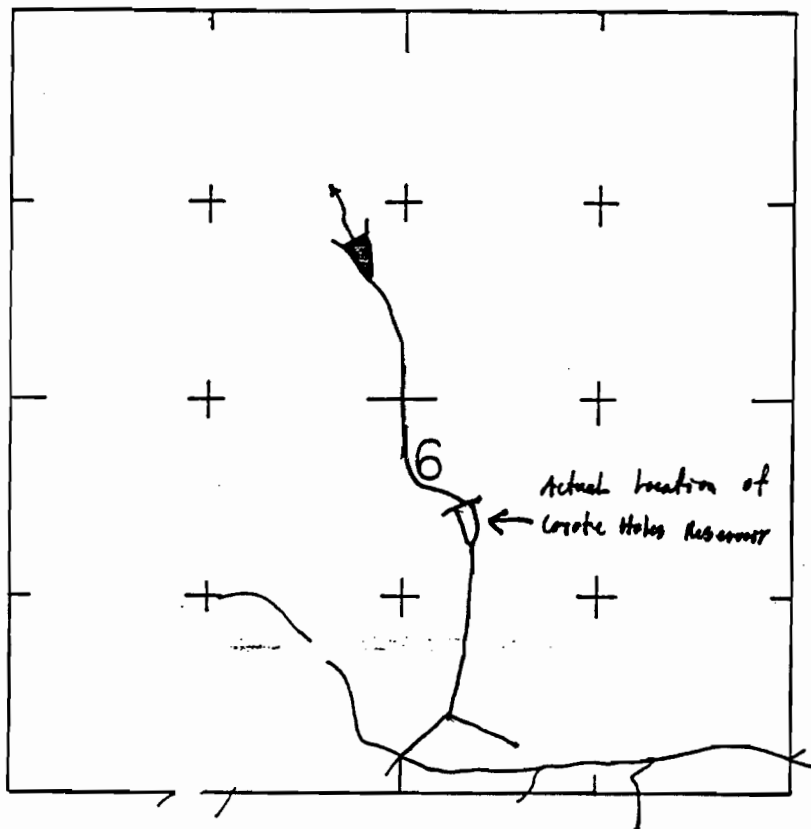

R-114799
R 7333

LIMITED
STATE ENGINEER
OREGON

U. S. DEPARTMENT OF THE INTERIOR
BUREAU OF LAND MANAGEMENT

COYOTE HOLES RES.
SE 4 NW 4 SEC 6 T35S R44E
W.M.

DESIGNED _____

RECOMM. _____

DRAWN *R.M.*

RECOMM. _____

CHECKED _____

APPROVED _____

CHIEF, DIV. OF ENG.

SCALE 4" = 1 mi

DATE June 10, 68

SHEET 1 OF 1

DRAWING NO.