

UNITED STATES
DEPARTMENT OF THE INTERIOR
BUREAU OF LAND MANAGEMENT

SECTION


NW 1/4 SW 4

Sec. 8

Oregon State Water Filings

TOWNSHIP 38^S, RANGE 40^E, W. M.

North

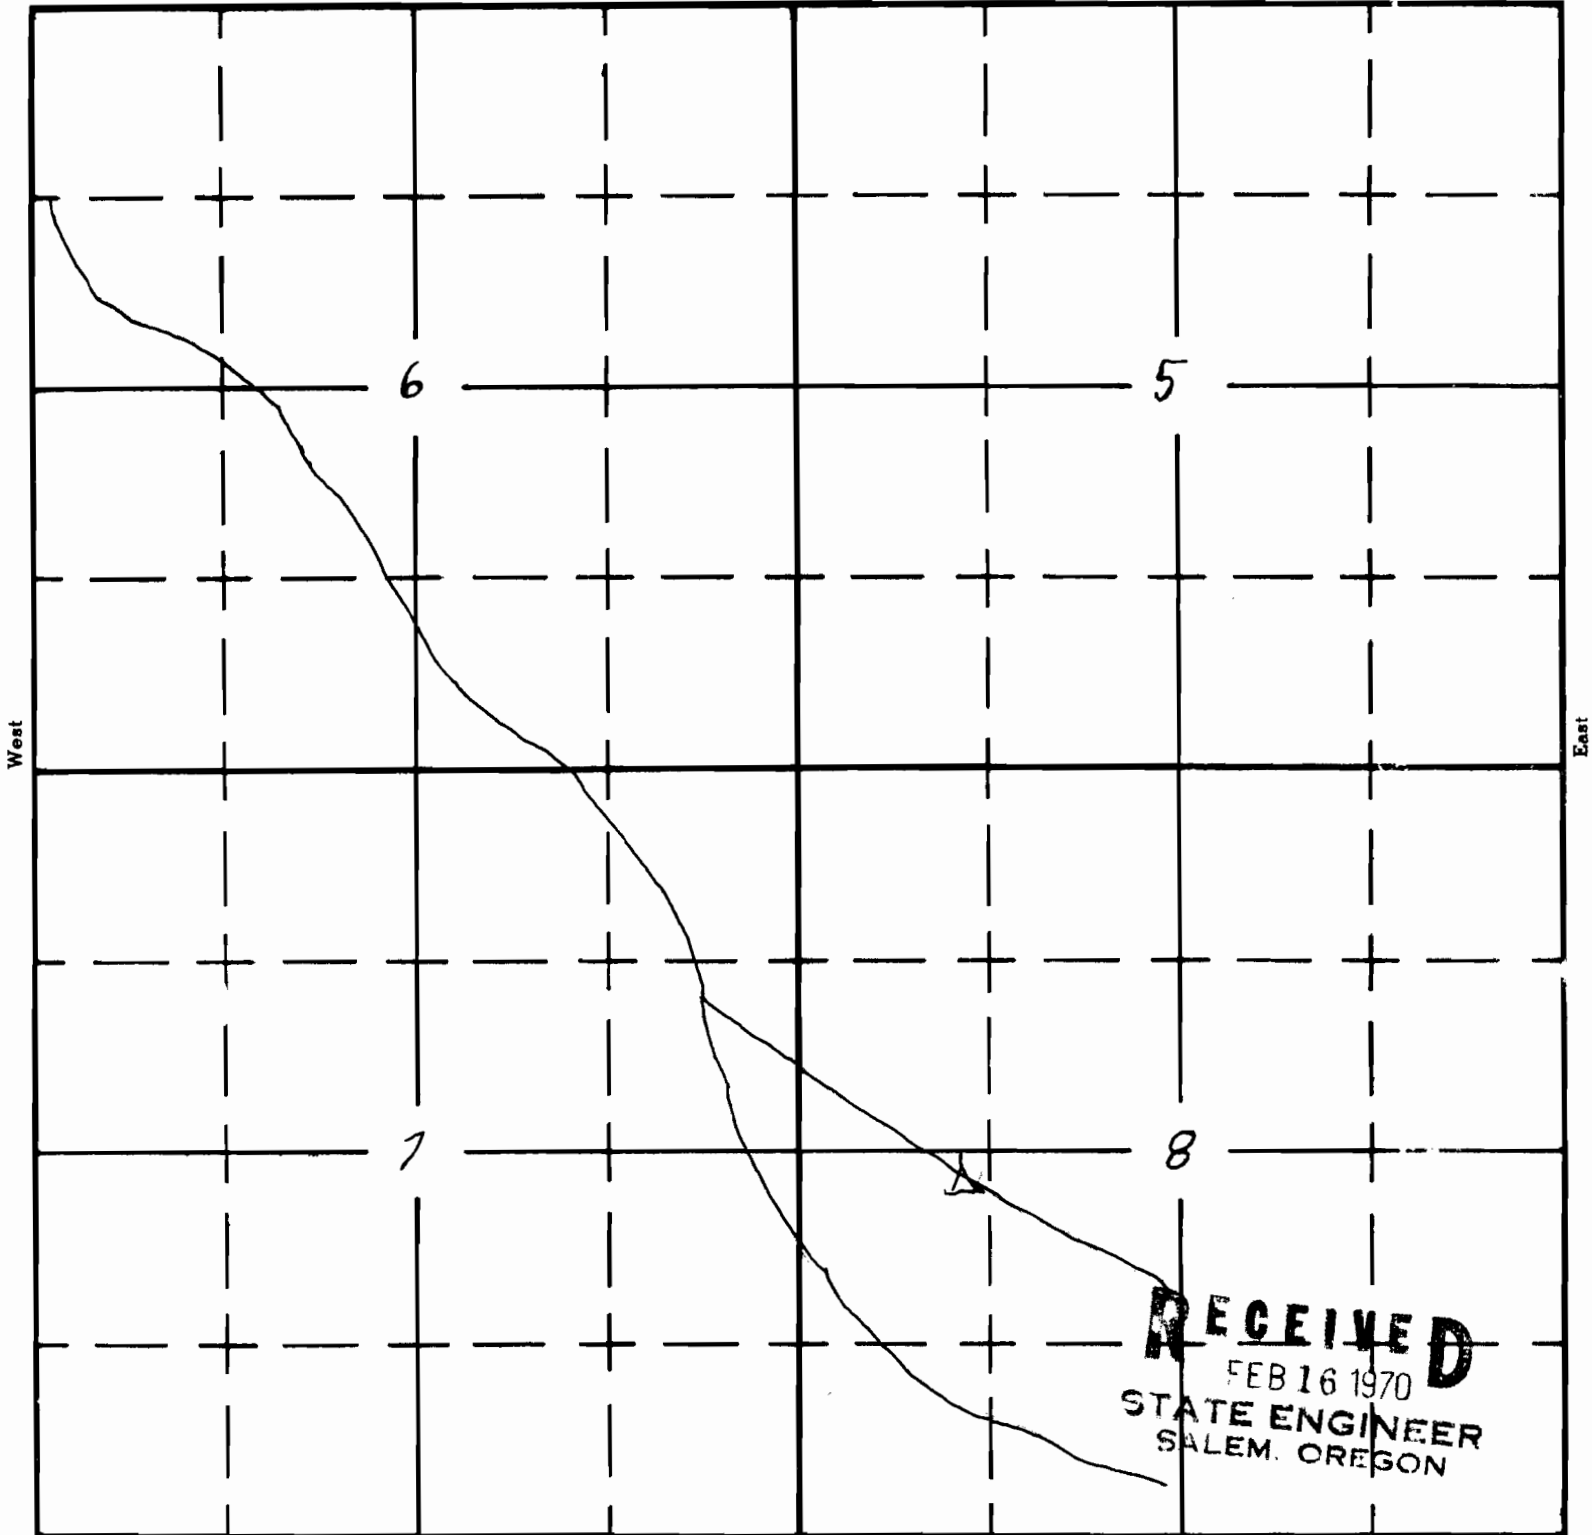

RECEIVED
FEB 16 1970
STATE ENGINEER
SALEM, OREGON

Miracle Res

South

APPLICATION No. R46744
PERMIT No. R 7493