

UNITED STATES
DEPARTMENT OF THE INTERIOR
BUREAU OF LAND MANAGEMENT

SECTION

30


Oregon State Water Filings

SE $\frac{1}{4}$ NE $\frac{1}{4}$

TOWNSHIP 40 S., RANGE 4 E., W. M.

SCALE 8" = 1 MI.

North

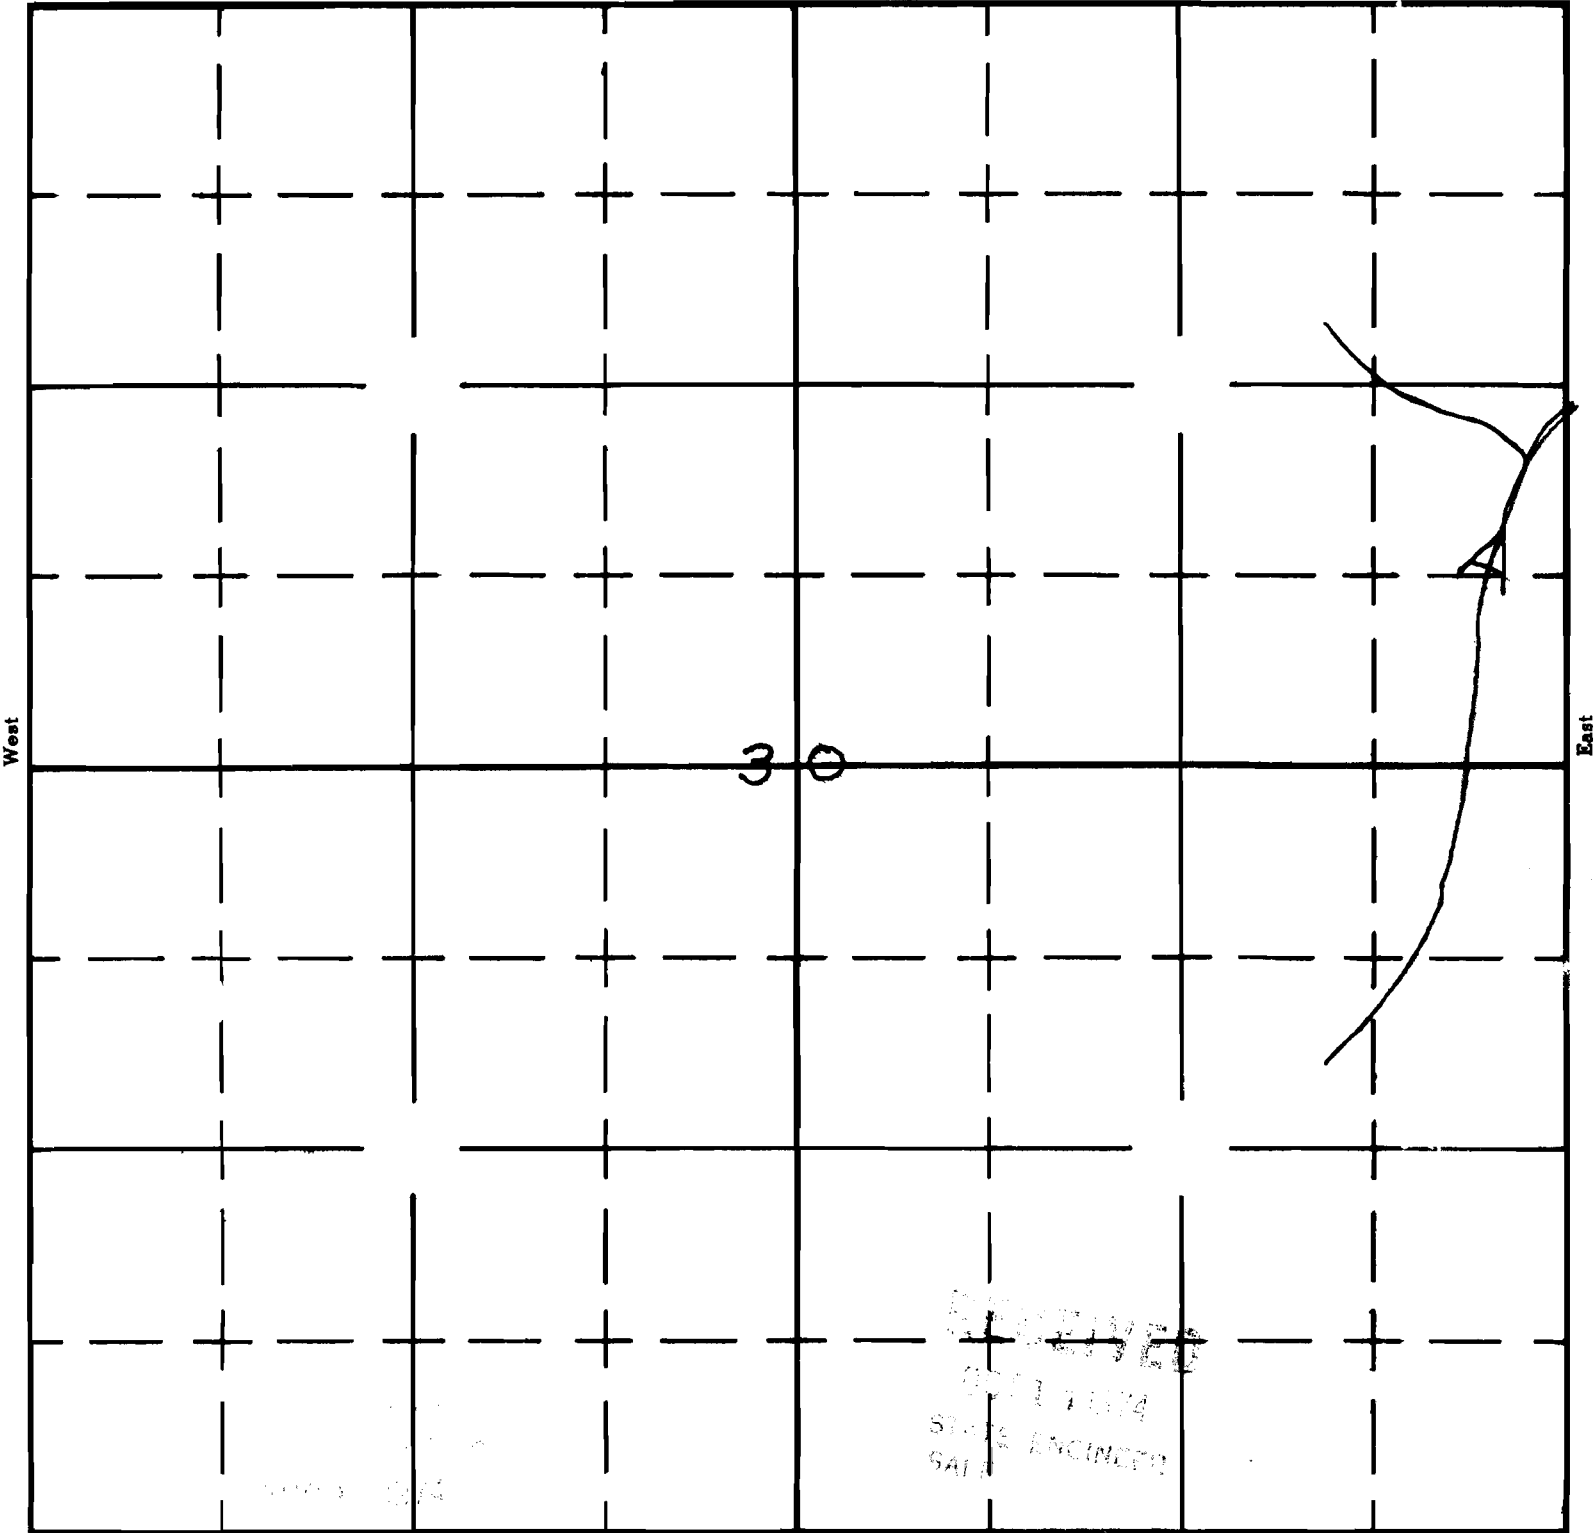

RECEIVED
OCT 1 1974
STATE ENGINEER
SALE

APPLICATION No. R-52289
PERMIT No. 7505