

RECEIVED

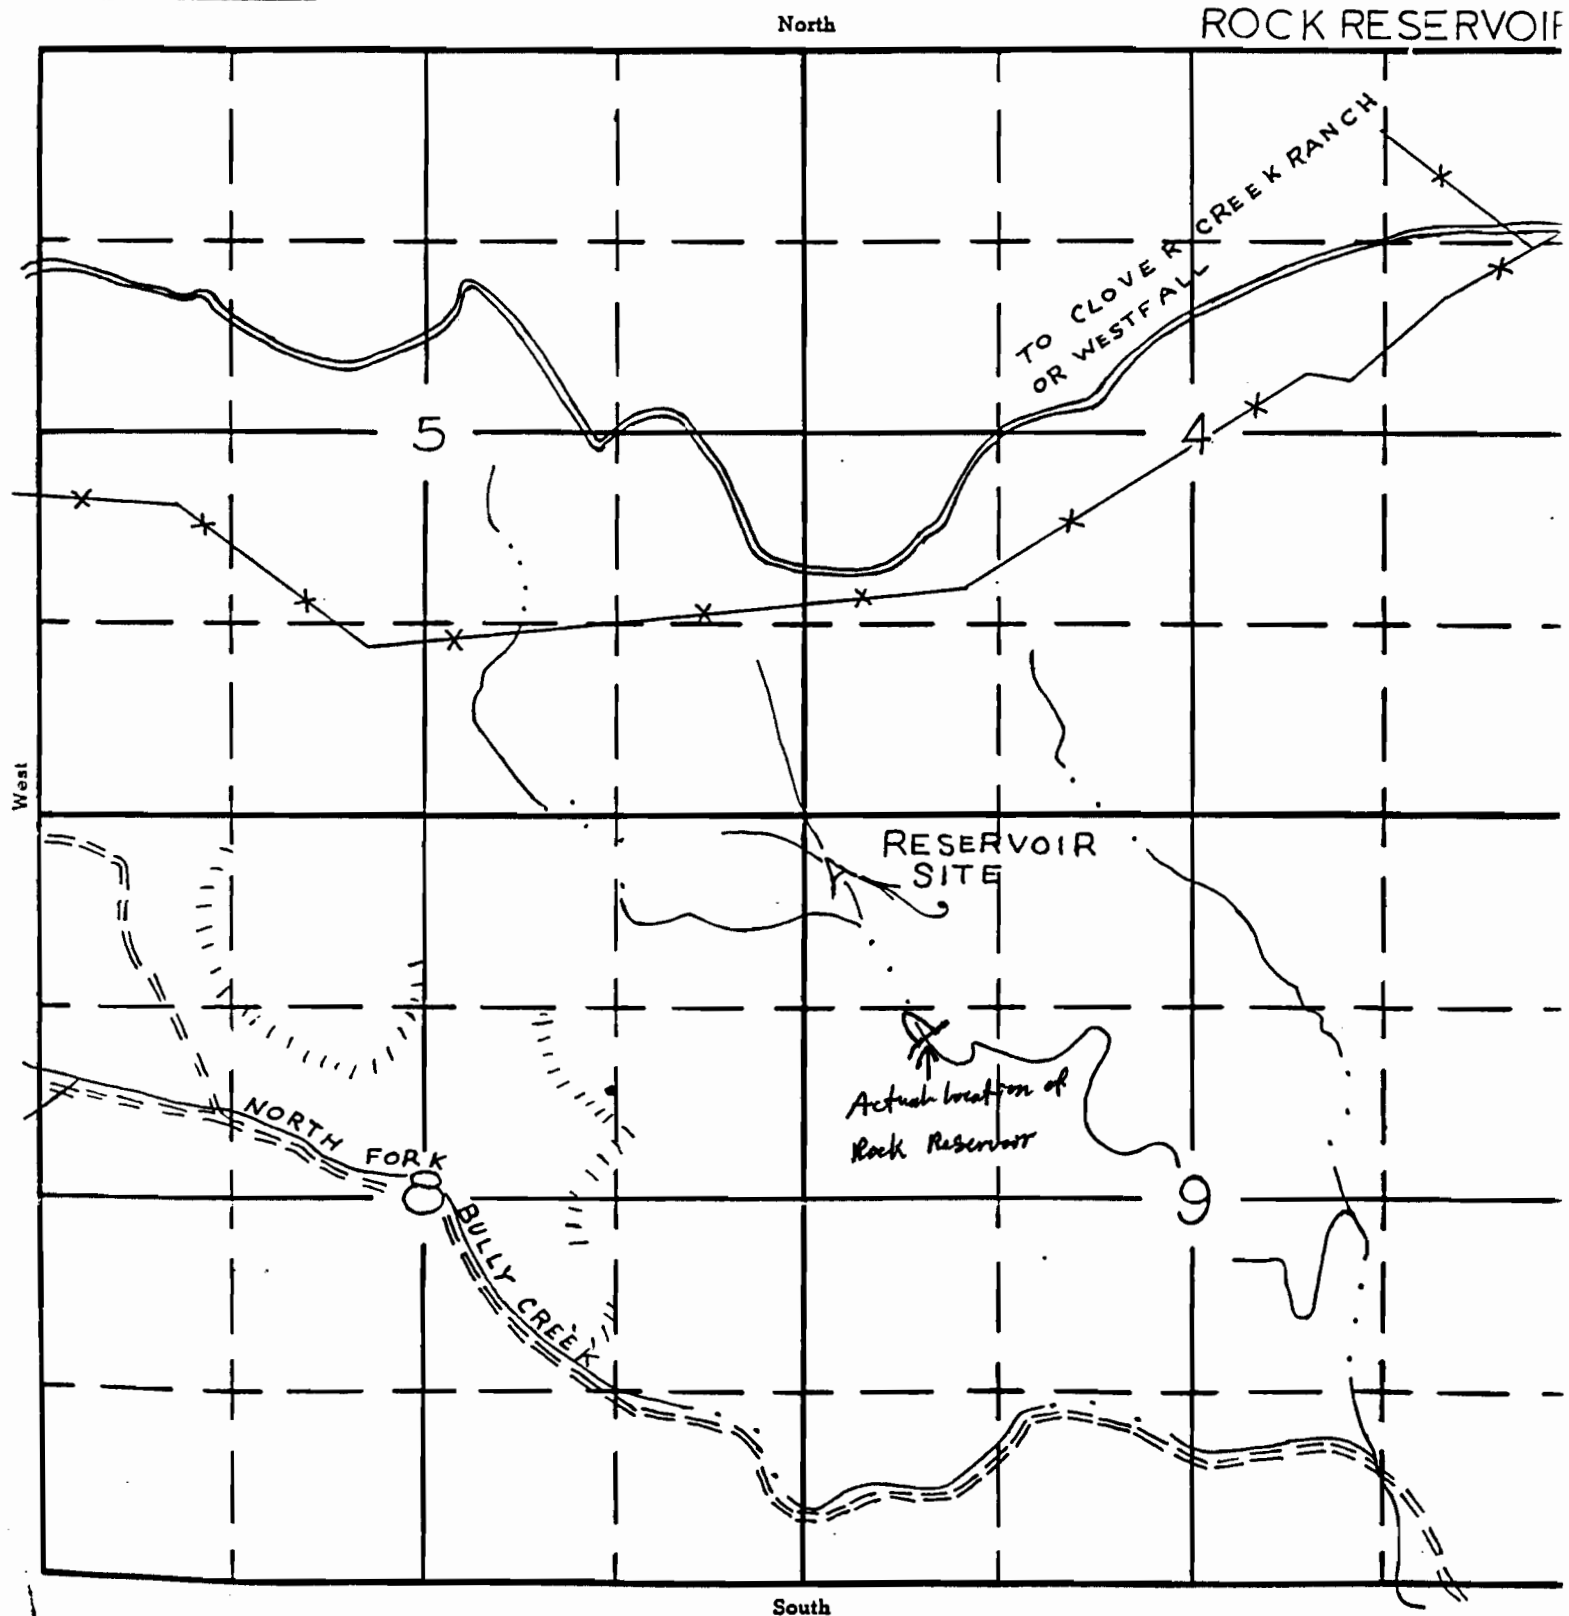
JUL 31 1997

WATER RESOURCES DEPT.
SALEM, OREGON

9

Oregon State Water Filings

NWN.W

TOWNSHIP 17 S., RANGE 39 E., W. M.

APPLICATION No. **R1064**
PERMIT No.