

Application No. R-73511


Permit No. 74869

"CERTIFICATE NO. 68914"

SECTION 15

SE 1/4 NW 1/4

TOWNSHIP 38^S RANGE 42^E W.M.

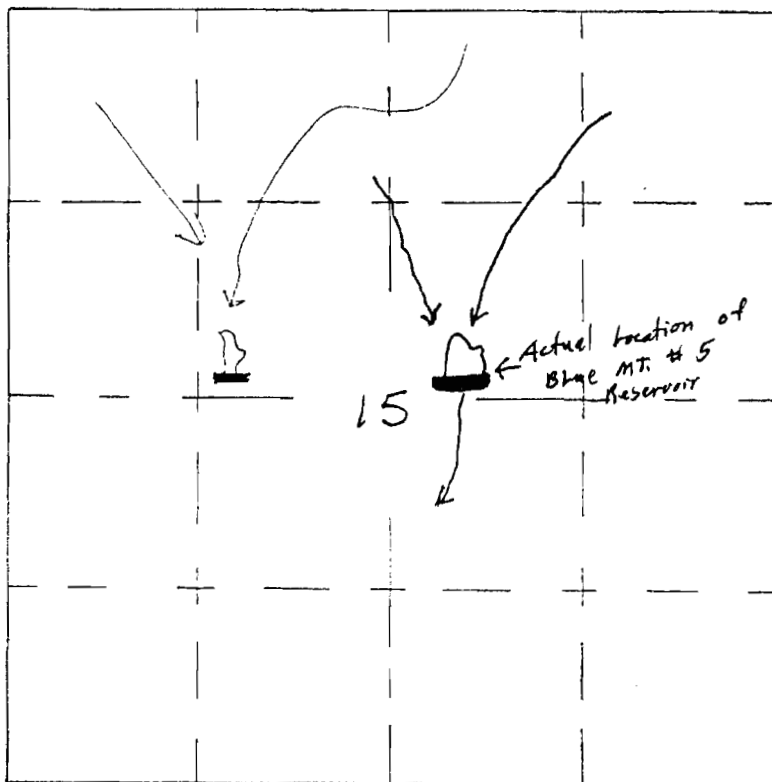

Application No. R59138

Permit No. R 8771

U. S. DEPARTMENT OF THE INTERIOR
BUREAU OF LAND MANAGEMENT

BLUE MT #5

DESIGNED _____	RECOMM. _____
DRAWN _____	RECOMM. _____
CHECKED _____	APPROVED _____

CHIEF, DIV. OF ENG.

SCALE _____

DATE _____

SHEET _____ OF _____

DRAWING NO. _____